

WATER SERVICE RECORD

Name

Service No.

Address

Location 15 UTICA ST

LOT 71

Repair—Renewal—New Service


Date	Material	Amount	Total	Date	Describe	Amount
11/14/58	24' 3/4 Coppe 3/4 x 1/2 S&W			Sept 7 6'	1" Copper 1" CorP 1" Curb Stop 1 x 3/4 Red bufflo box Exst 3/4 Corb left in Place behind wall	
					<div style="border: 1px solid black; padding: 2px; display: inline-block;"># 15</div> 29.5 13.5	

DATE _____

TOWN OF LEXINGTON — BOARD OF PUBLIC WORKS

WATER DIVISION

Sketch of Service Here

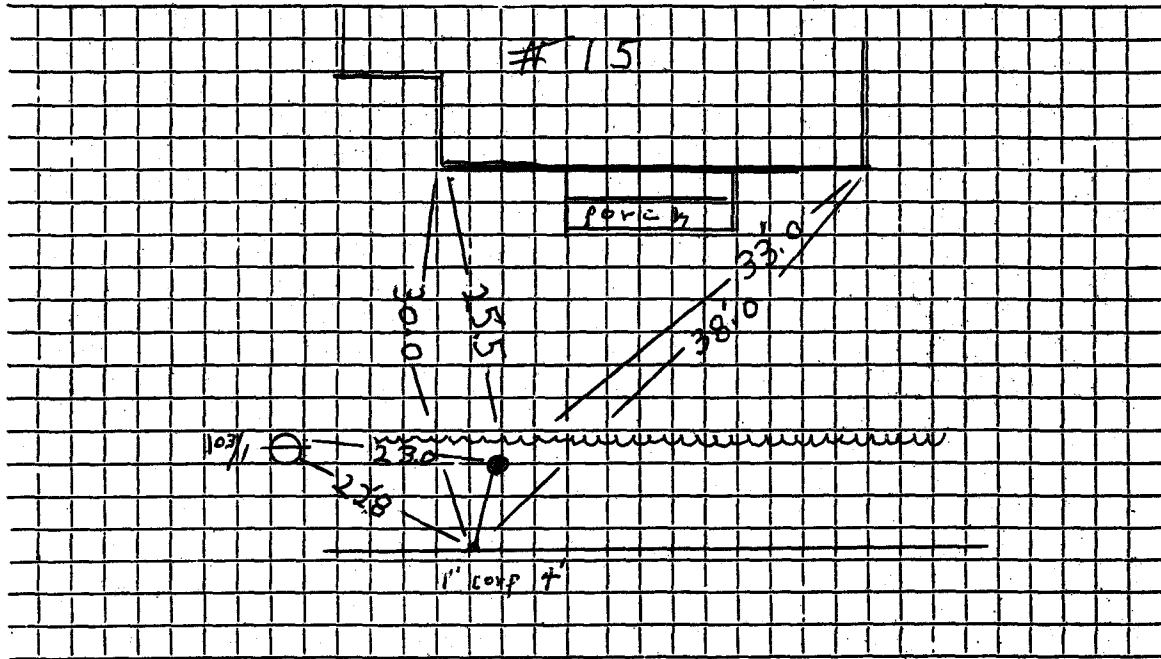

Connection made in Street. Work completed

Remarks: 3/4" Curb left in place behind wall

