




DATE \_\_\_\_\_

TOWN OF LEXINGTON — BOARD OF PUBLIC WORKS

WATER DIVISION

Sketch of Service Here

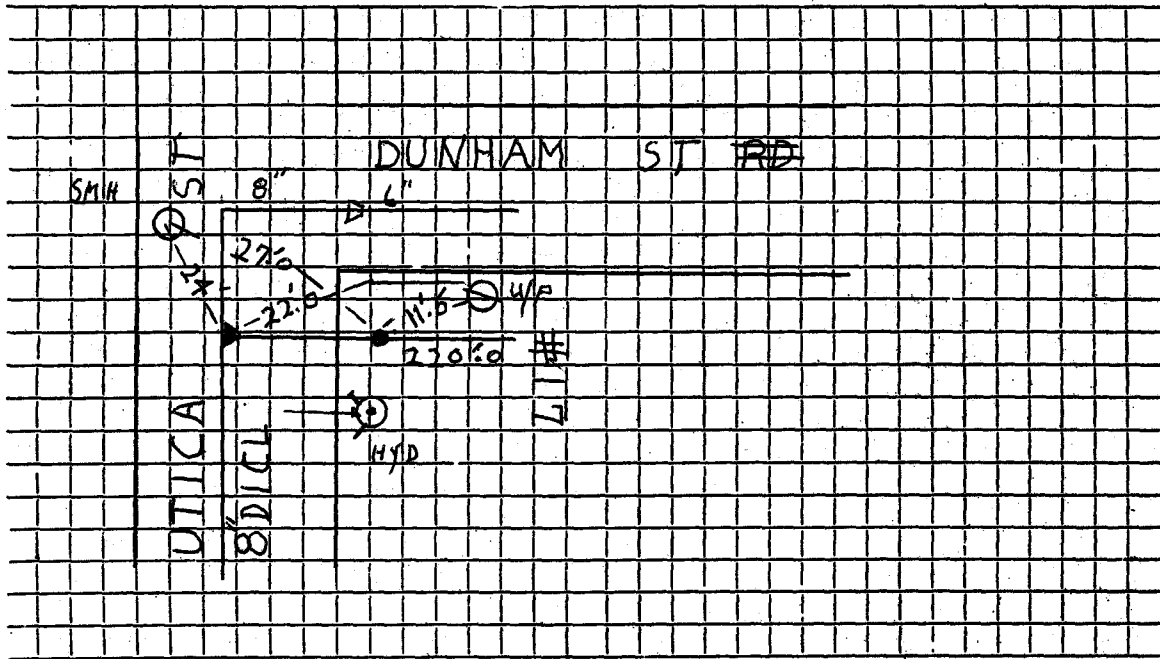

Connection made in ..... Street. Work completed 9/4/07 R.f.l.s.e.....

Remarks: New 1" Cop. Tied into Existing 1" Copper.....