


DATE _____

TOWN OF LEXINGTON — BOARD OF PUBLIC WORKS

WATER DIVISION

Sketch of Service Here

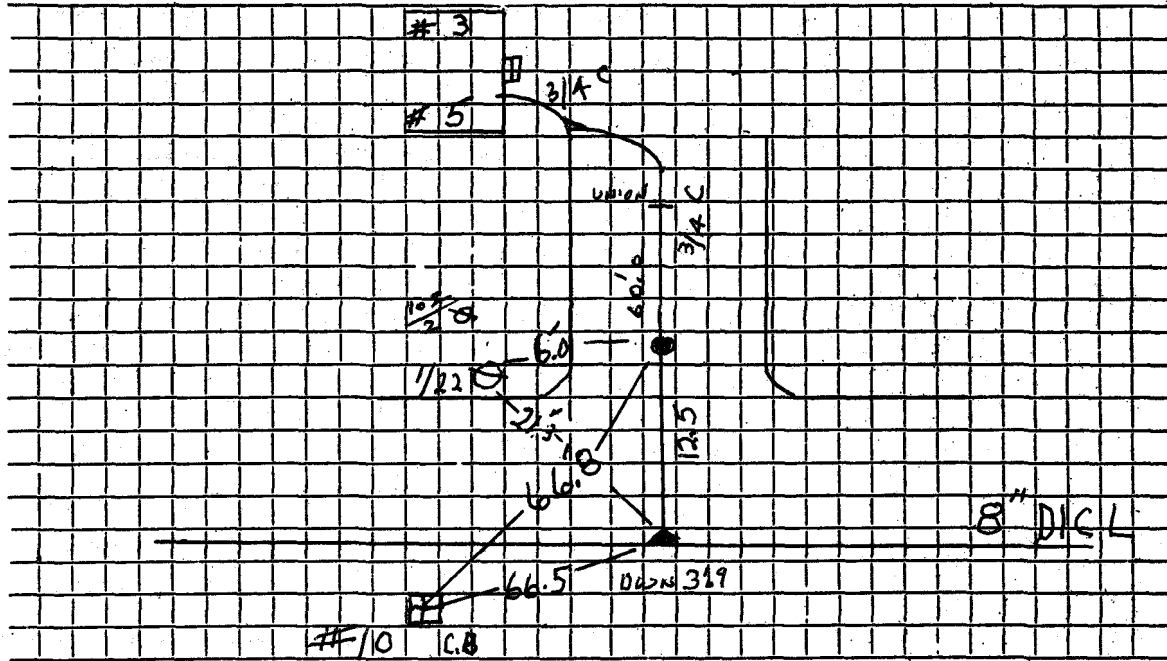

Connection made in Street. Work completed *Sept. 07. R. f. l. c. e.*

Remarks: *120'-31A Cop. p. 1-Union*