


TOWN OF LEXINGTON - BOARD OF PUBLIC WORKS
 WATER DIVISION

Date: 4/24/21

SKETCH OF SERVICE HERE

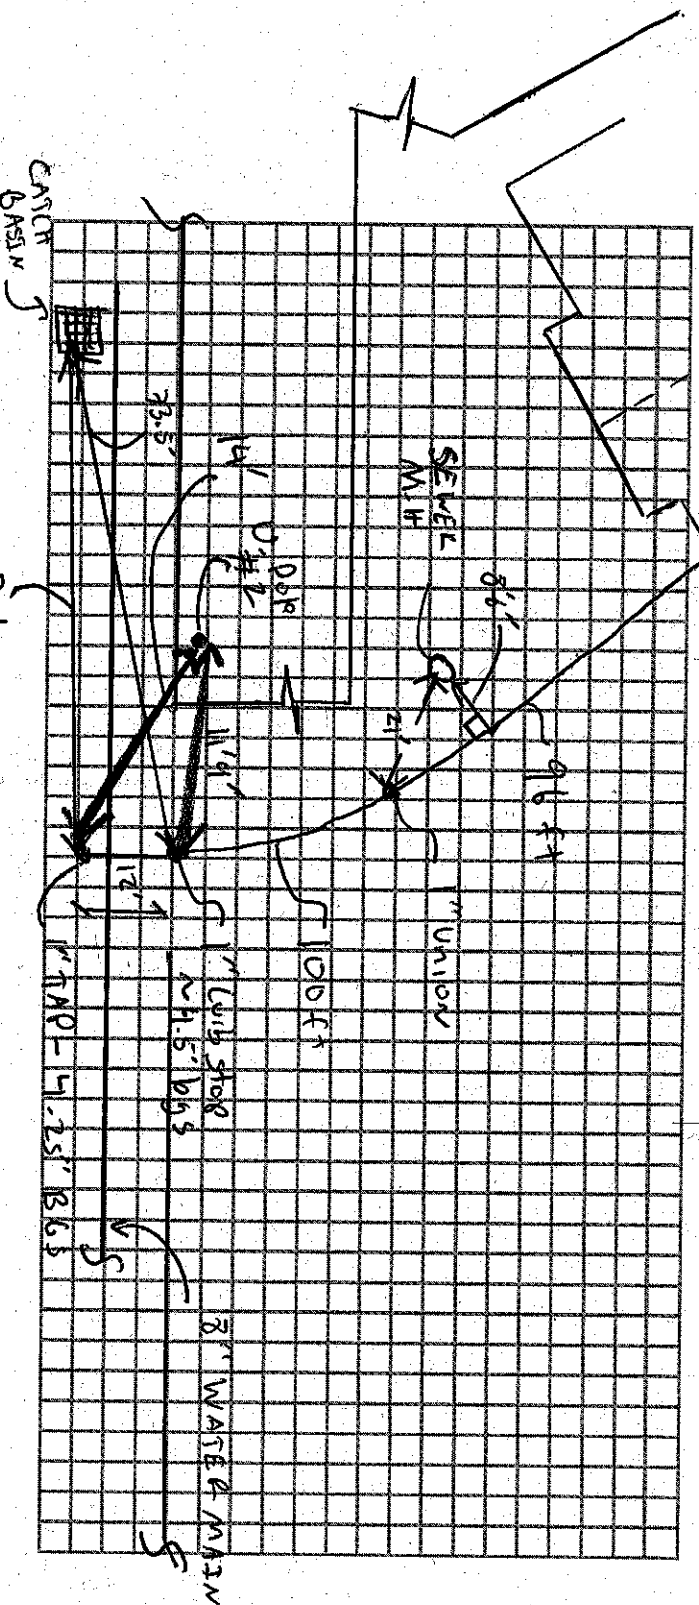

Connection made in: UTICA ST

Street:

Work completed:

Remarks: * #3 Hrs a New tap into 6\"/>

Water Service Record

Name McLaughlin, James M. JNL

Service No. W-21-22

Address 2 UTICA ST

Location

Repair - Renewal New Service

Date	Material	Amount	Total	Date	Amount
4/26/21	ROAD → HOUSE				
	1" X 8" TAP INTO	(1)			
	TOWN LINE				
	1" TYPE K LINE	12 ft			
	1" L.S. # BUT. BOX	(1)			
	1" TYPE K LINE	106 ft			
	1" UNION	(1)			
	1" TYPE K LINE	96 ft			