


TOWN OF LEXINGTON - BOARD OF PUBLIC WORKS
WATER DIVISION

Date: 4/26/21

SKETCH OF SERVICE HERE

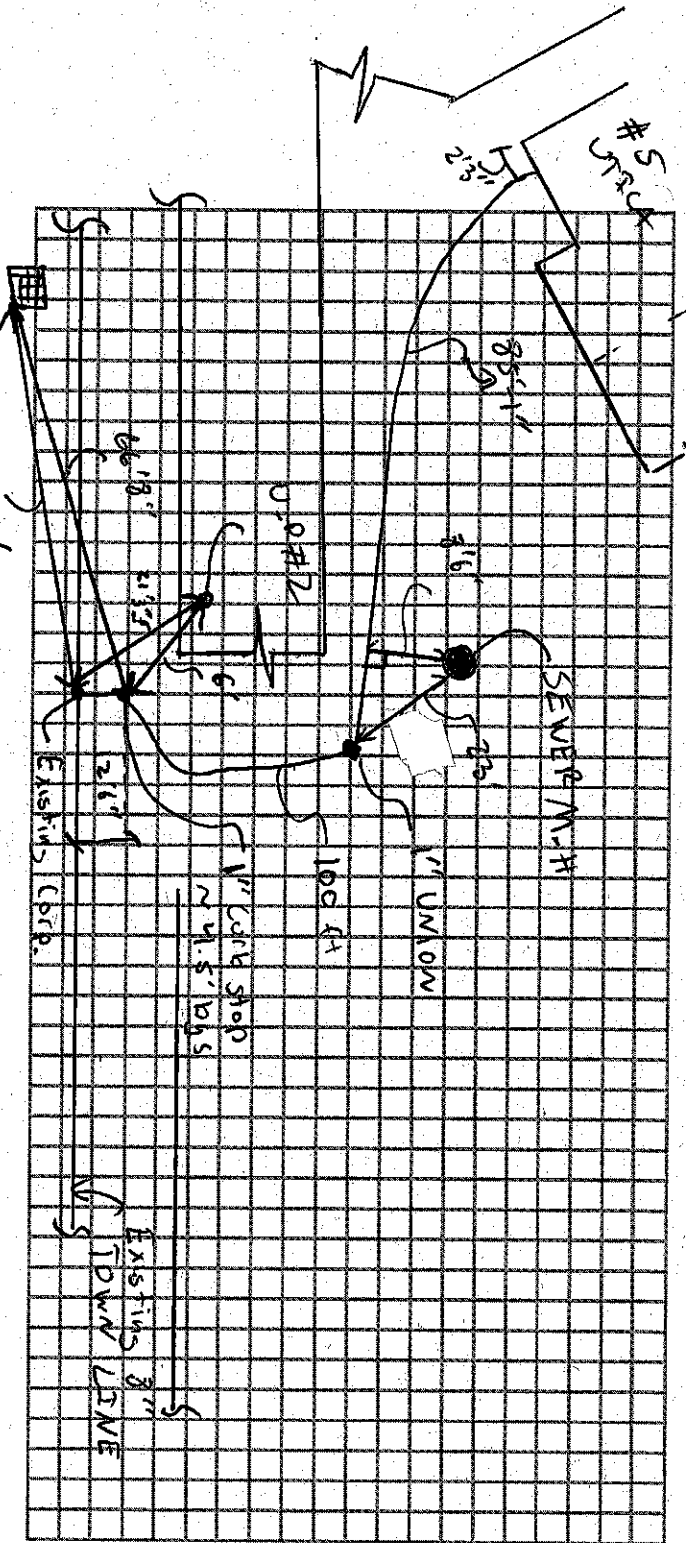

Connection made in: UTICA Street: _____ Work completed:
Remarks: #5 connection into existing culb stop

