




DATE 8/7/18

TOWN OF LEXINGTON — BOARD OF PUBLIC WORKS

WATER DIVISION

Sketch of Service Here

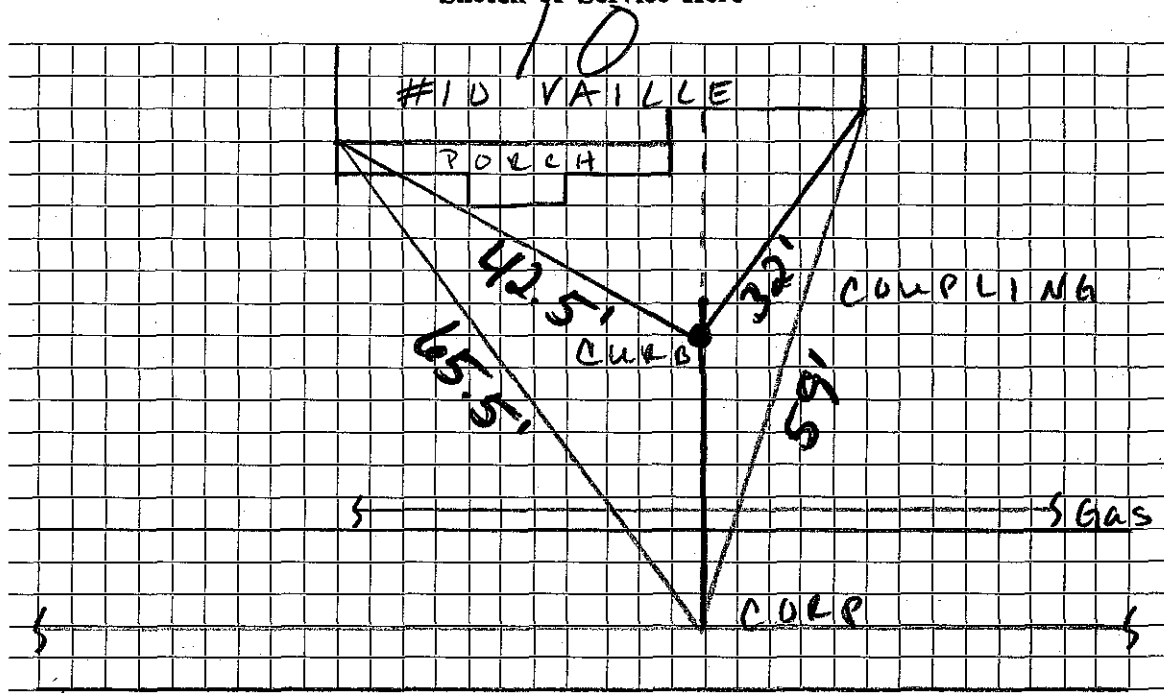

Connection made in Vaille Ave Street. Work completed .....

Remarks: New 1" Water service from curb to main .....

Water service laid underneath gas line .....