

WATER SERVICE RECORD

Name *Marissa Liggiero*
 Address *12 Vaille Ave*
 Location _____
~~Repair~~ ~~Renewal~~ New Service

Service No. _____

Contractor: *Ventresca, Inc.*


Date		Material	Amount	Total	Date		Amount
						<i>CURB to MAIN</i>	
							<i>DEPTH</i>
						<i>Coupling 7/8" x 1"</i>	
						<i>1" Copper</i>	
						<i>1" Curb stop</i>	
					<i>25'</i>	<i>1" Copper</i>	
						<i>1" Corporation</i>	
						<i>type K pipe</i>	
						<i>open right</i>	
						<i>camb. brass</i>	

DATE 8/18

TOWN OF LEXINGTON — BOARD OF PUBLIC WORKS

WATER DIVISION

Sketch of Service Here

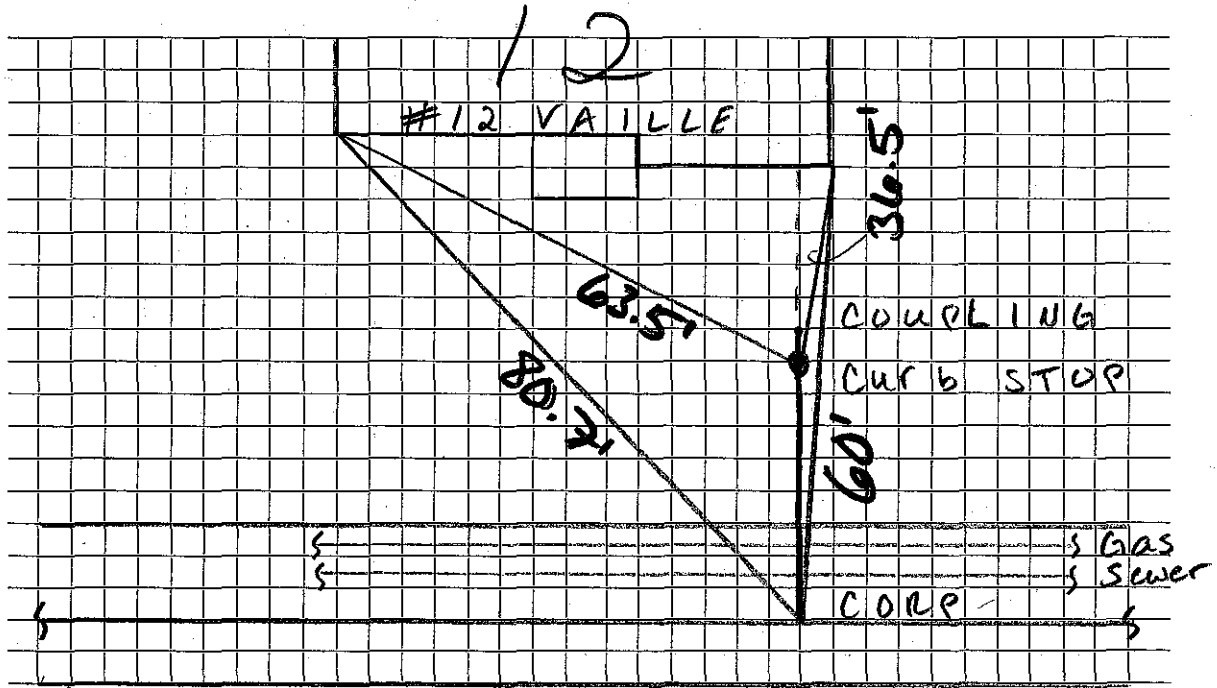

Connection made in Vaille Ave Street. Work completed

Remarks: New 1" Water Service from curb to main
Water service underneath gas & sewer lines