

Name Harry M. Hogan

Service No. 260

Address 12 Vaille Avenue

Lexington, Mass.

Locatio 12 Vaille Avenue

Kind of Pipe

Size

Size of Main

~~Repair~~ ~~Renewal~~ — New Service

Com. 11-6-50

Location

Date	Material	Amount	Total	Date	Location	Amount
Sept. 12, '50	Labor	2 96	2 96	Aug 22 '50	Deposited	28 00
	10% Overhead		30			
	40' - 3/4" Copper Tubing @.275		11 00		No Charge	29 27
	1 - 3/4"C x 1/2" I.W.H. S&W		3 76	Sept. 12, '50	Labor	3 00
	Littlefield Shovel 1 1/2 hrs. @7.00	10 50	10 50	20' - 3/4" Copper Tubing @.275		5 50
	Trucking 1 hr. @.75		75	1 - 3/4"C Corp-cock		3 60
			29 27	1 - 3/4"C x 3/4"C Curb-cock		4 40
				1 - Box & Rod		3 35
				1 - 1/8" Offset Tail Piece		42
				1 - 1/8" Straight Tail Piece		42
				Littlefield Shovel 1 hr. @ 7.00		7 00
				Trucking 1 hr. @.75		75
	Labor					28 44

Hadley Press, Inc., Lexington

DATE _____

TOWN OF LEXINGTON—BOARD OF PUBLIC WORKS

WATER DIVISION

The undersigned applies for a supply of water at No. _____ St. and hereby agrees to comply with the rules and regulations as now, or at any future time, established by the Board of Selectmen.

Am't. of Estimate \$ _____


Owner _____

Am't. Paid \$ _____

Address _____

Builder _____

Sketch of Service Here

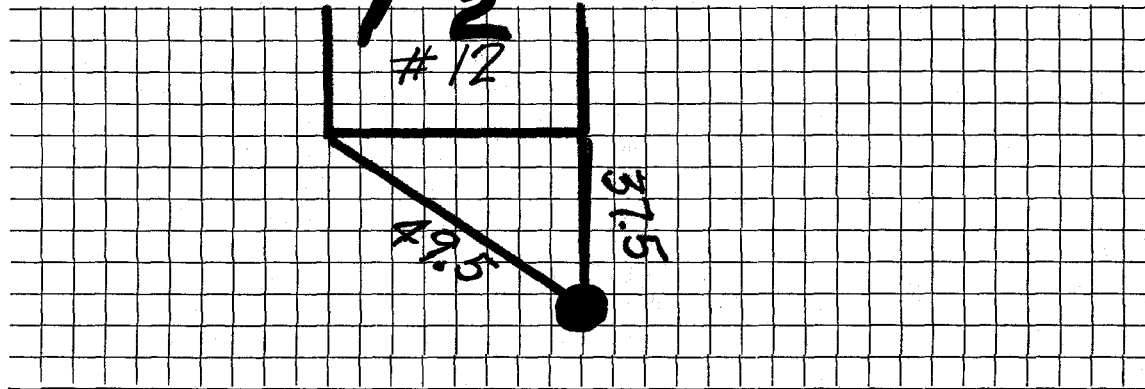

Connection made in _____ Street.

Work completed _____ 19

Remarks: