

WATER SERVICE RECORD

Name Dave Paulik

Service No.

Address 15 Vaille Ave

Location

Contractor: Ventresca, Inc.

~~Repair~~ ~~Renewal~~ New Service


Date	Material	Amount	Total	Date	Amount
	EXISTING			8/1/18	CURB to MAIN
	CURB to HOUSE				DEPTH
	3/4" Copper				1" x 3/4" Coupling
					1" Copper
					1" Curb Stop
				18'	1" Copper
					1" Corporation
					5'
					type k pipe
					open riser
					amb. brass

DATE 8/1/2018

TOWN OF LEXINGTON — BOARD OF PUBLIC WORKS

WATER DIVISION

Sketch of Service Here

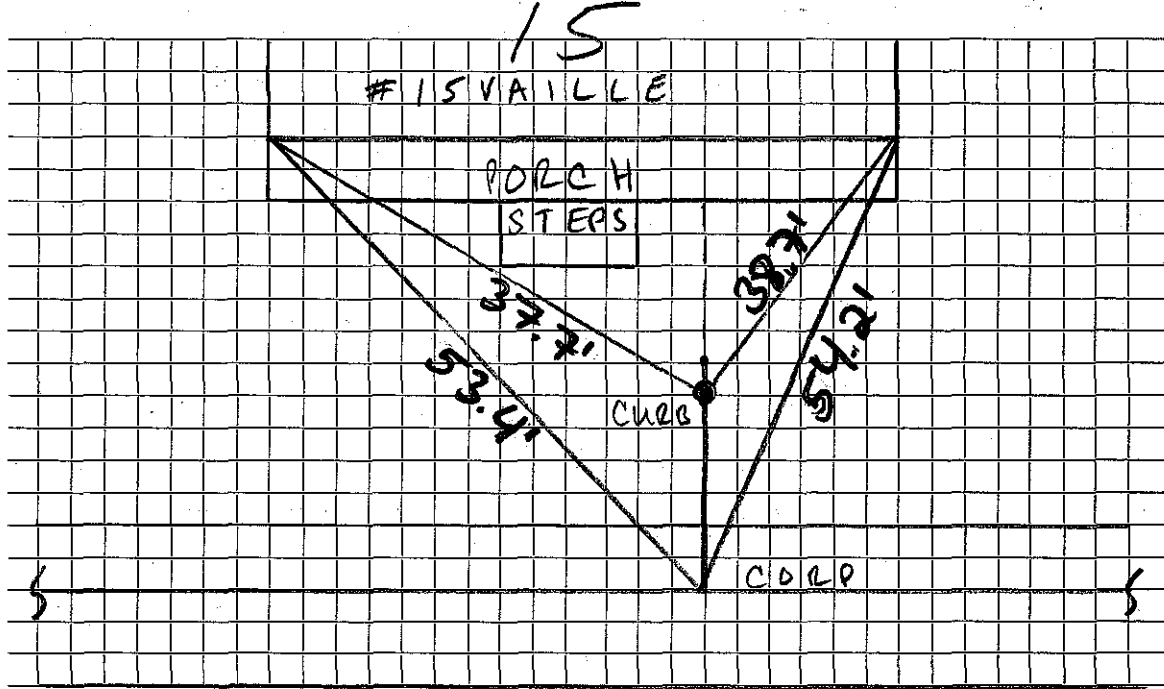

Connection made in... VAILLE AVE Street. Work completed

Remarks:.. New 1" Water service from curb to new main