

WATER SERVICE RECORD

Name *Marissa Liggiero*

Service No.

Address *16 Vaile Ave*

Location

Contractor: *Ventresca, Inc.*

~~Repair~~—Renewal—New Service


| Date | Material    | Amount | Total | Date | Amount             |
|------|-------------|--------|-------|------|--------------------|
|      | EXISTING    |        |       |      | CURB to MAIN       |
|      | 3/4" Copper |        |       |      | 1" x 3/4" Coupling |
|      |             |        |       |      | 1" Copper          |
|      |             |        |       |      | 1" Curb stop       |
|      |             |        |       |      | 23.5' 1" Copper    |
|      |             |        |       |      | type K pipe        |
|      |             |        |       |      | open ript          |
|      |             |        |       |      | comb brass         |

DATE \_\_\_\_\_

# TOWN OF LEXINGTON — BOARD OF PUBLIC WORKS

## WATER DIVISION

Sketch of Service Here

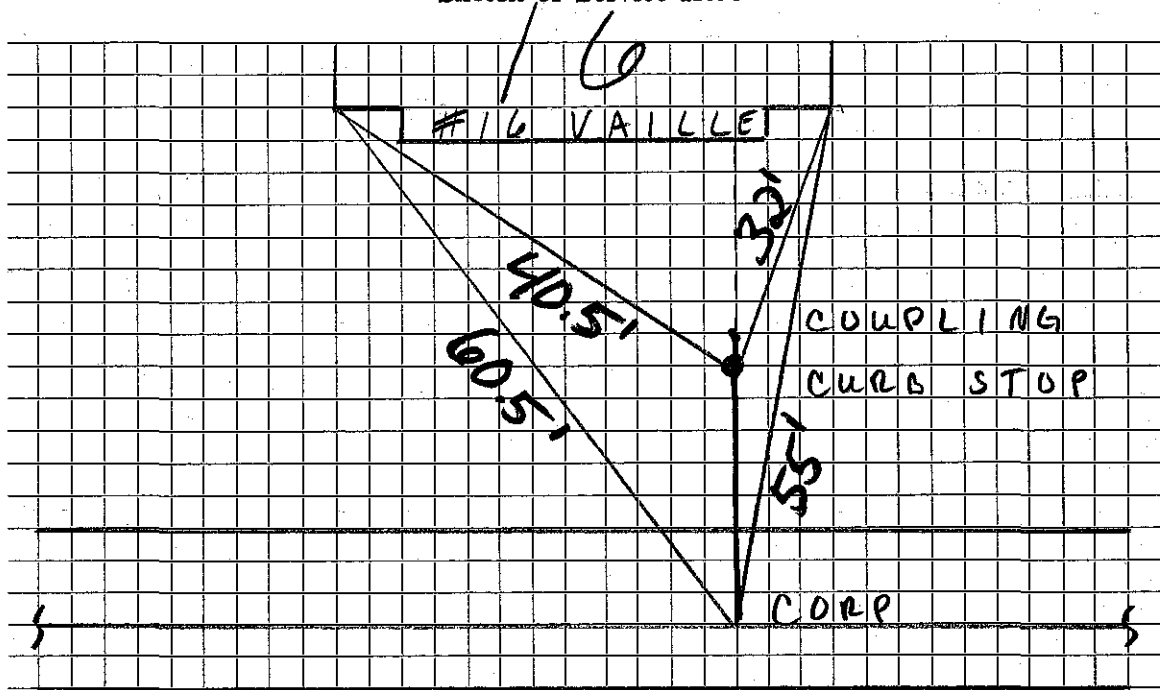

Connection made in Vaille Ave Street. Work completed .....

Remarks: New 1" Water service from curb to MAIN