

WATER SERVICE RECORD

FEB 15 1965

Name Clarence W. Barry

Service No. 113

Address 16 Vaille Avenue

Location

~~Renewal~~ Renewal ~~W.O. #9244~~ W.O. #9244


FEB 15 1965

Date	Material	Amount	Total	Date	Amount	
10-7-64	Labor	53.30		9-18-64	Deposit	125.00
	10% O.H.	5.33	58.63	2-16-65	Returned	11.38
57'	3/4" Copper tubing @.42		23.94			113.62
1	3/4 x 1/2 Compressor		9.29		CURB TO MAIN	
1	3/4" 3 part union		3.01	10-7-64	Labor	22.44
1 1/2	hrs. Town Shovel @6.50		9.75	24'	3/4" Copper tubing @.42	10.08
1	hr. Town Truck		3.00	1	3/4" Corp. Cock	7.41
1/2	hr. Loader @4.00		2.00	1	3/4" Curb Cock	8.76
1	hr. Trailer @4.00		4.00	1	Box & Rod	4.90
			113.62	1	1/2 Offset	.50
				1	1/2 Tailpiece	.50
				1/2	hr. Town Shovel	3.25
				1	hr. Town Truck	3.00
				1/2	hr. Loader	2.00
						62.84

TOWN OF LEXINGTON — BOARD OF PUBLIC WORKS

WATER DIVISION

Sketch of Service Here

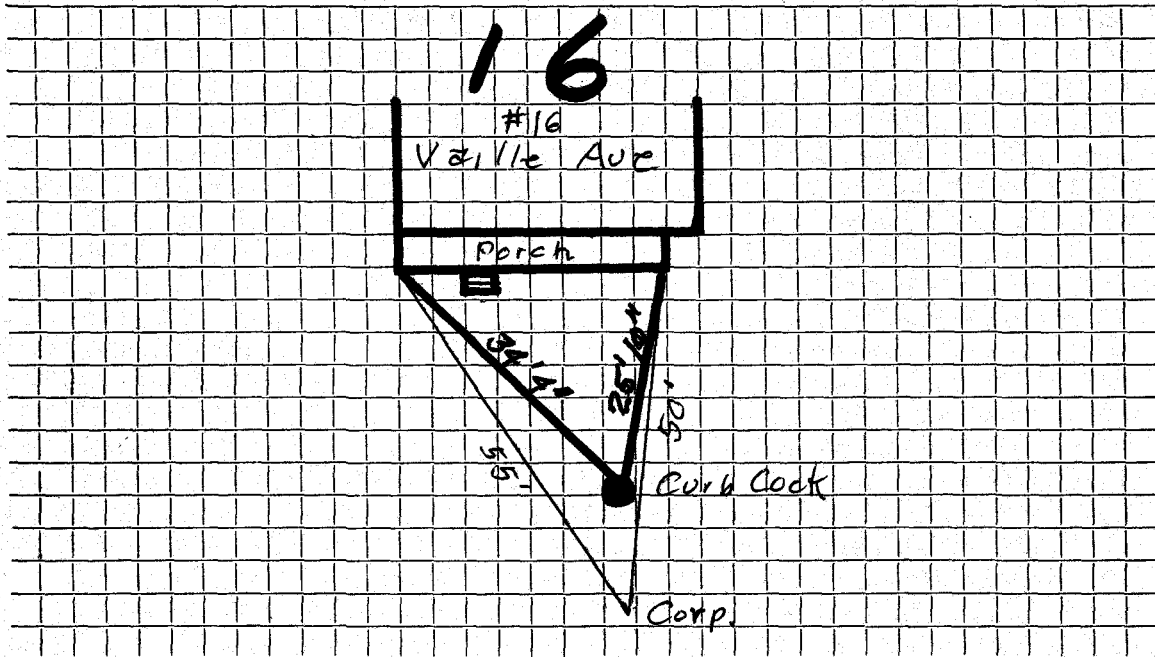

Connection made in Street. Work completed

Remarks: Original Service 6-14-68

.....

.....