

WATER SERVICE RECORD

Name *Marissa Liggiero*

Service No.

Address *20 Vaille Ave*

Location

Contractor: *Ventresca, Inc.*


~~Repair~~ ~~Renewal~~ New Service

Date	Material	Amount	Total	Date	Amount
	<i>EXISTING</i>				<i>CURB to MAIN</i>
	<i>3/4" Copper</i>				<i>1" x 3/4" Coupling</i>
					<i>1" Copper</i>
					<i>1" Curb Stop</i>
					<i>35' 1" Copper</i>
					<i>1" Corporation</i>
					<i>type k pipe</i>
					<i>open right curb</i>
					<i>comb. brass</i>

DATE 8/3/18

TOWN OF LEXINGTON — BOARD OF PUBLIC WORKS  
WATER DIVISION

Sketch of Service Here

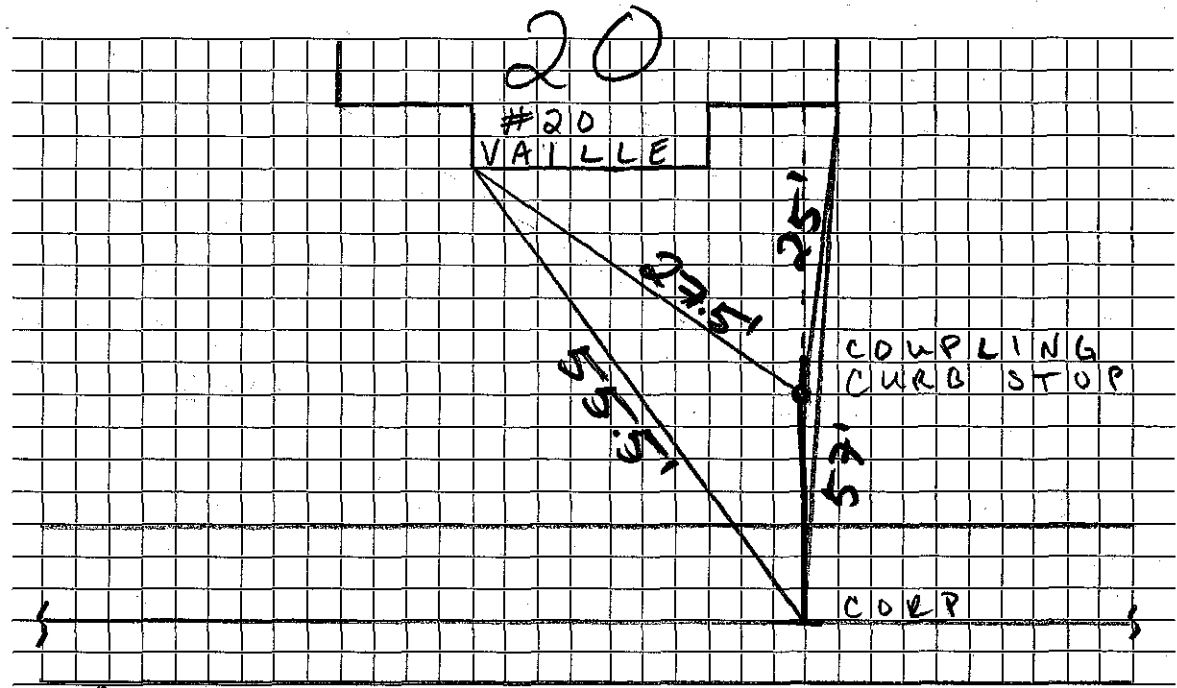

Connection made in... Vuille Ave ..... Street. Work completed .....

Remarks: ... New 1" Water service from curb to main. .....