

WATER SERVICE RECORD

Name J.E. Cumming

Service No. 256

Address 20 Vaille Avenue

#6885

Location

~~Repair~~ ~~Renewal~~ ~~New Service~~


Cmn 12-11-60

Date	Material	Amount	Total	Date	Amount
11-2-60	Labor	1 94		11-2-60	50 00
	10% overhead	19		11-2-60	12 24
			2 13		32 24
	57' 3/4" copper tubing @ .42	23 94			
	1 3/4" Cx 1/2 IWH stop & waste	6 17			
			32 24		
				12' 3/4" Copper tubing @ .42	5 04
				1 3/4" C Corp Cock	4 91
				1 3/4" C Curb Cock	6 28
				1 box & rod	4 90
				1 1/2 Str. Tail Pc.	50
				1 1/2 Offset Tl. Pc.	50
					23 74
				2-5-65	FREZE

TOWN OF LEXINGTON — BOARD OF PUBLIC WORKS

WATER DIVISION

Sketch of Service Here

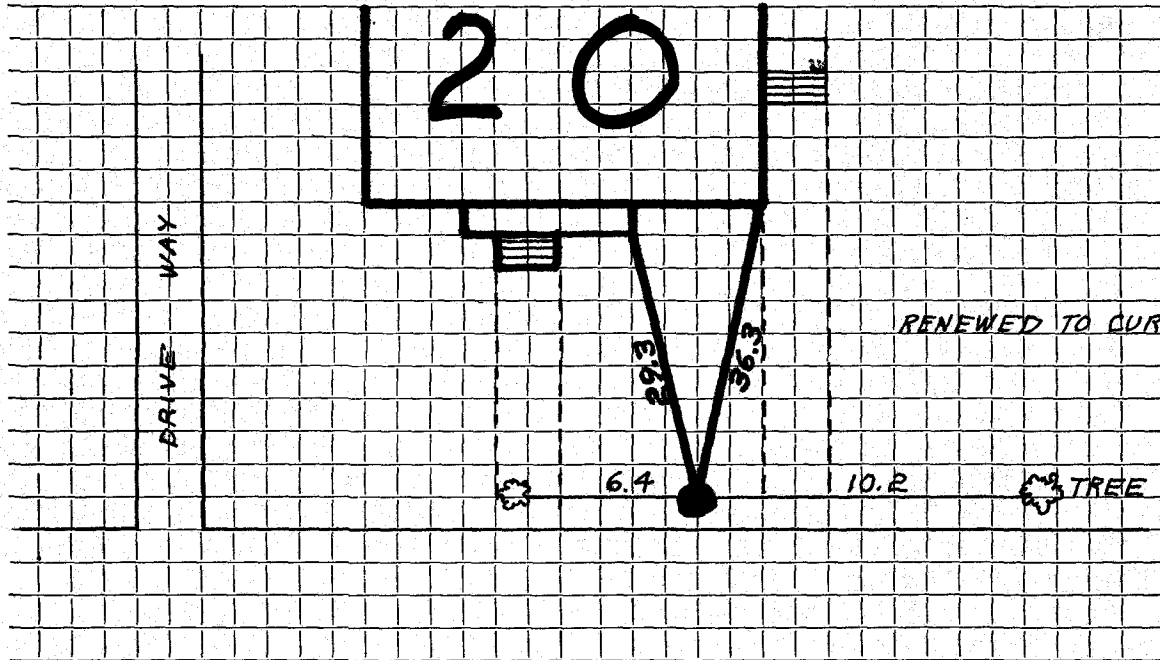

Connection made in Street. Work completed

Remarks:

.....
.....