

WATER SERVICE RECORD

Name Dave Pavlik

Service No.

Address 21 Vaille Avenue

Location

Contractor: Ventresca, Inc.


Repair—Renewal—New Service

Date	Material	Amount	Total	Date	Amount
				8/1/18	CURB to MAIN
					DEPTH
				8/1/18	1" x 3/4" coupling
				8/1/18	1" copper
				8/1/18	1" curb stop
				8/1/18	15' 1" copper
				8/1/18	1" corporation
					5.0'
					5.3'
					type k copper
					open right curb
					chamb. brass

DATE 8/1/2018

TOWN OF LEXINGTON — BOARD OF PUBLIC WORKS
WATER DIVISION

Sketch of Service Here

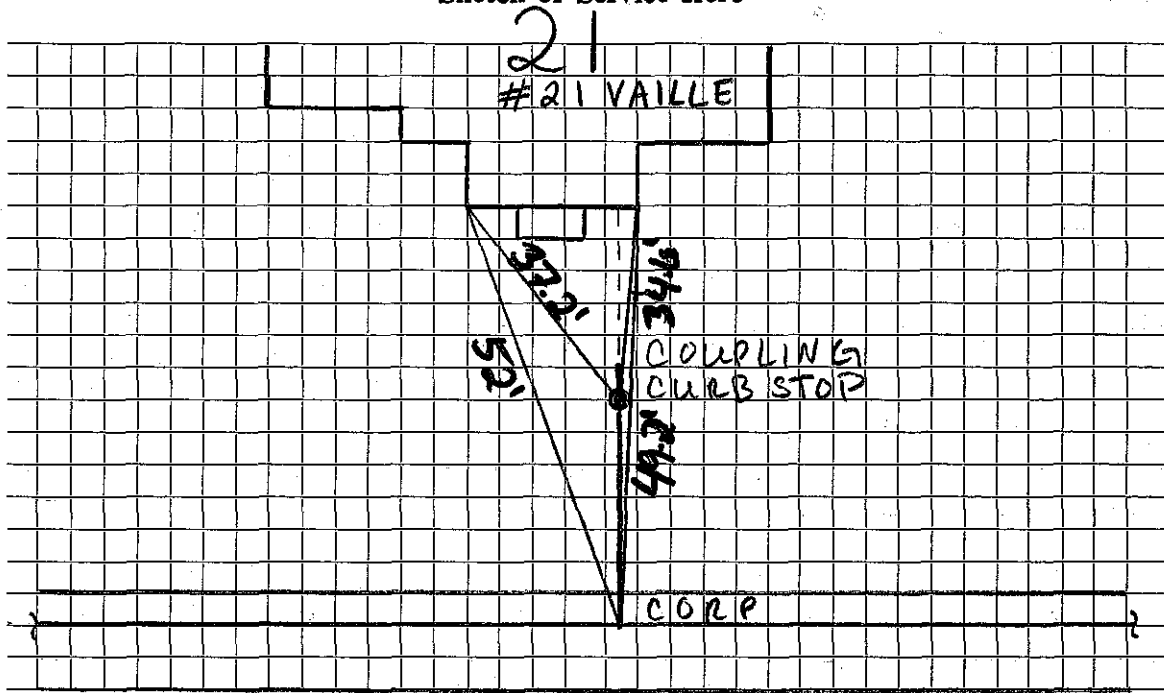

Connection made in Vaille Ave Street. Work completed

Remarks: Dotted line indicates existing line.

New 1" water service from curb to main