


DATE 9-9-94

TOWN OF LEXINGTON — BOARD OF PUBLIC WORKS

WATER DIVISION

Sketch of Service Here

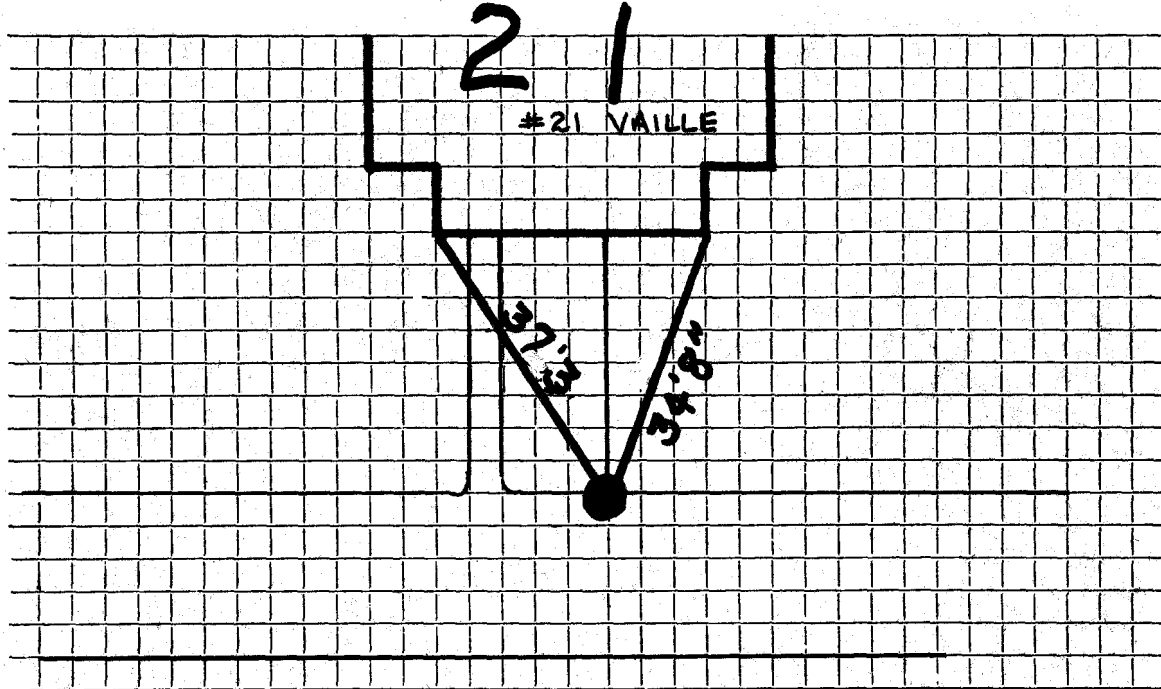

Connection made in ... VAILLE AVE Street. Work completed

Remarks: Original Service 6-14-68