

WATER SERVICE RECORD

Name Dave Pavlik
 Address 24 Vaille Ave

Service No.

Location Contractor: Ventresca, Inc.


~~Repair~~ ~~Renewal~~ New Service

Date	Material	Amount	Total	Date	Amount
	EXISTING			8/2/12	CURB to MAIN
	CURB to HOME				DEPTH
	3/4" Copper				1" x 3/4" Coupling
				6"	1" Copper
					1" Curb Stop 5.2'
				26'	1" Copper
					1" Corporation 4.6'
					type K pipe
					open right curb
					cambr. brass

DATE 8/2/2018

TOWN OF LEXINGTON — BOARD OF PUBLIC WORKS

WATER DIVISION

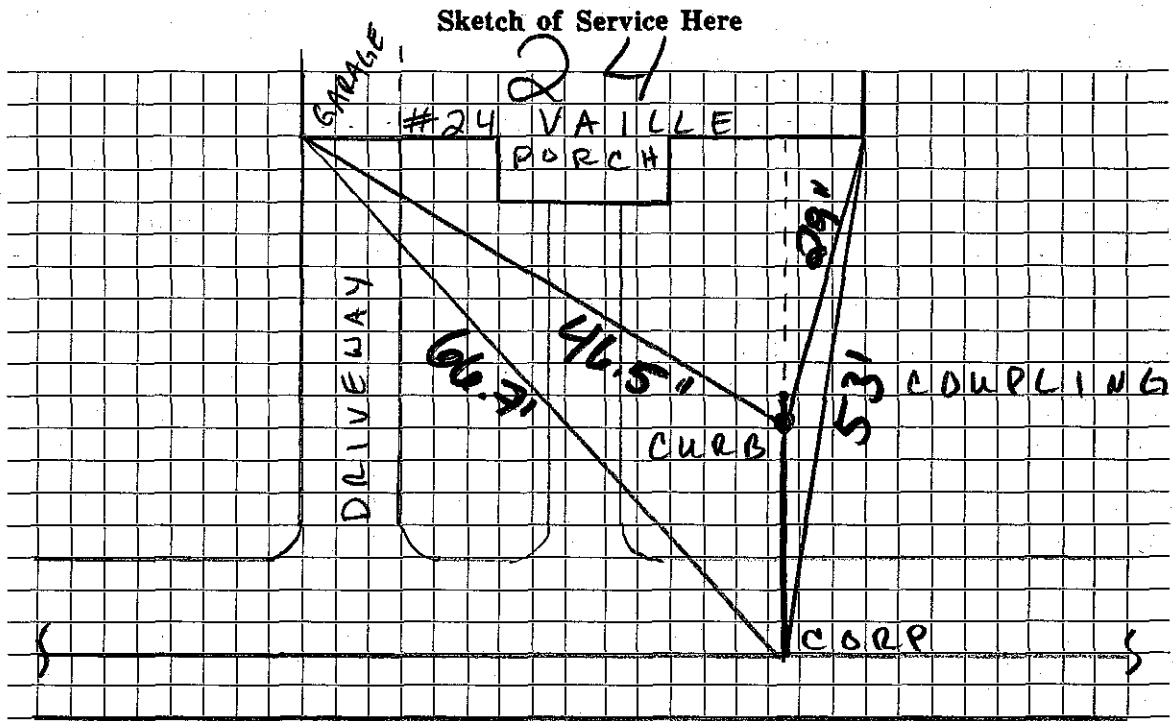

Connection made in Vaile Ave Street. Work completed

Remarks: New 1" water service from curb to MAIN