

Name

Service No. 2715

Address

24 Vail Ave. # 1700

1700

Location

24 Vail Avenue.

Kind of Pipe

Size

Size of Main

Repair—Renewal—New Service

Location

Date

Material

Amount

Total

Date

Amount

Labor

TOWN OF LEXINGTON—BOARD OF PUBLIC WORKS

WATER DIVISION

The undersigned applies for a supply of water at No. _____ St. and hereby agrees to comply with the rules and regulations as now, or at any future time, established by the Board of Selectmen.

Am't. of Estimate \$ _____


Owner Millem.

Am't. Paid \$ _____

Address 24 Vaill Ave

Builder _____

Sketch of Service Here

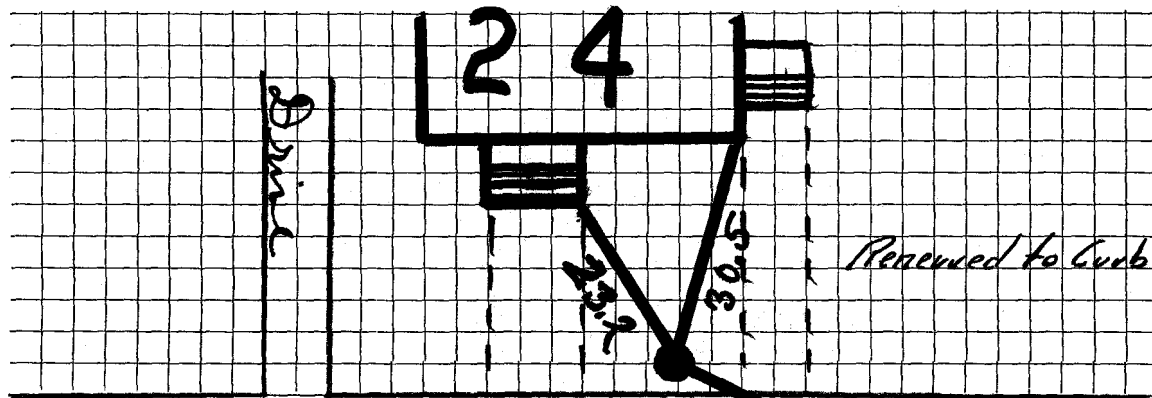

Connection made in Vaill Ave Street.

Work completed _____ 19

Remarks:

49.1 Spale