

WATER SERVICE RECORD

Name Dave Pavlik

Service No.

Address 26 Vaille Ave

Location

Contractor: Ventresca, Inc.

Repair ~~Renewal~~ New Service


Date	Material	Amount	Total	Date	Amount
	EXISTING CURB to HOME 3/4" Copper			8/2/18	CURB to MAIN DEPTH
					1" x 3/4" Coupling
					1" Copper
					1" Curb Stop 5'
				24'	1" Copper
					1" Corporation 4.2'
					type k pipe
					open right curb
					comb. brass

DATE 8/2/2018

TOWN OF LEXINGTON — BOARD OF PUBLIC WORKS

WATER DIVISION

Sketch of Service Here

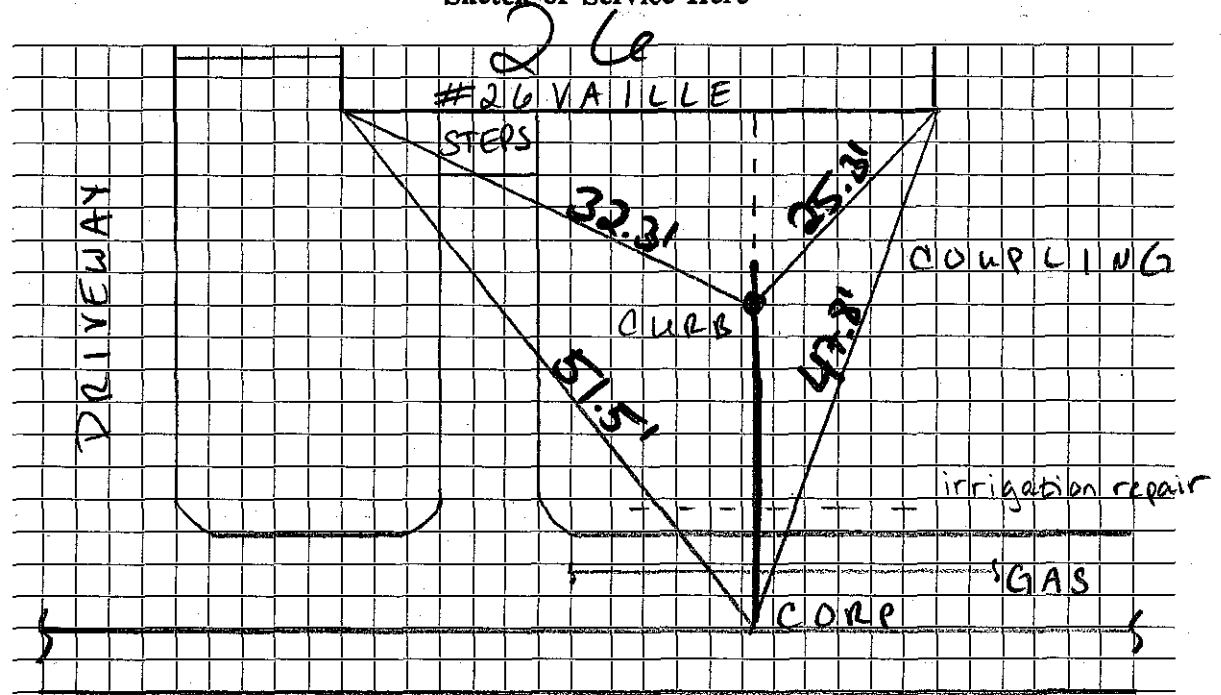

Connection made in Vaille Ave Street. Work completed from curb to MAIN
Remarks: New 1" Water service