

WATER SERVICE RECORD

Name Marissa Liggiero

Service No.

Address 27-31 Vaille Ave

Location

Contractor: Ventresca, Inc.

~~Repair~~—~~Renewal~~—New Service

Date	Material	Amount	Total	Date	Amount
	EXISTING			7/31/18	CURB to MAIN
	CURB to HOME				1" x 1 1/4" Coupling
	1 1/4" Copper				1" Copper
					1" Curb stop
					20' 1" Copper
					1" Corporation
					type K pipe
					open right curb
					comb. brass


DATE 7/31/2018

TOWN OF LEXINGTON — BOARD OF PUBLIC WORKS
WATER DIVISION

Sketch of Service Here

27-31

#27-31 VAILLE

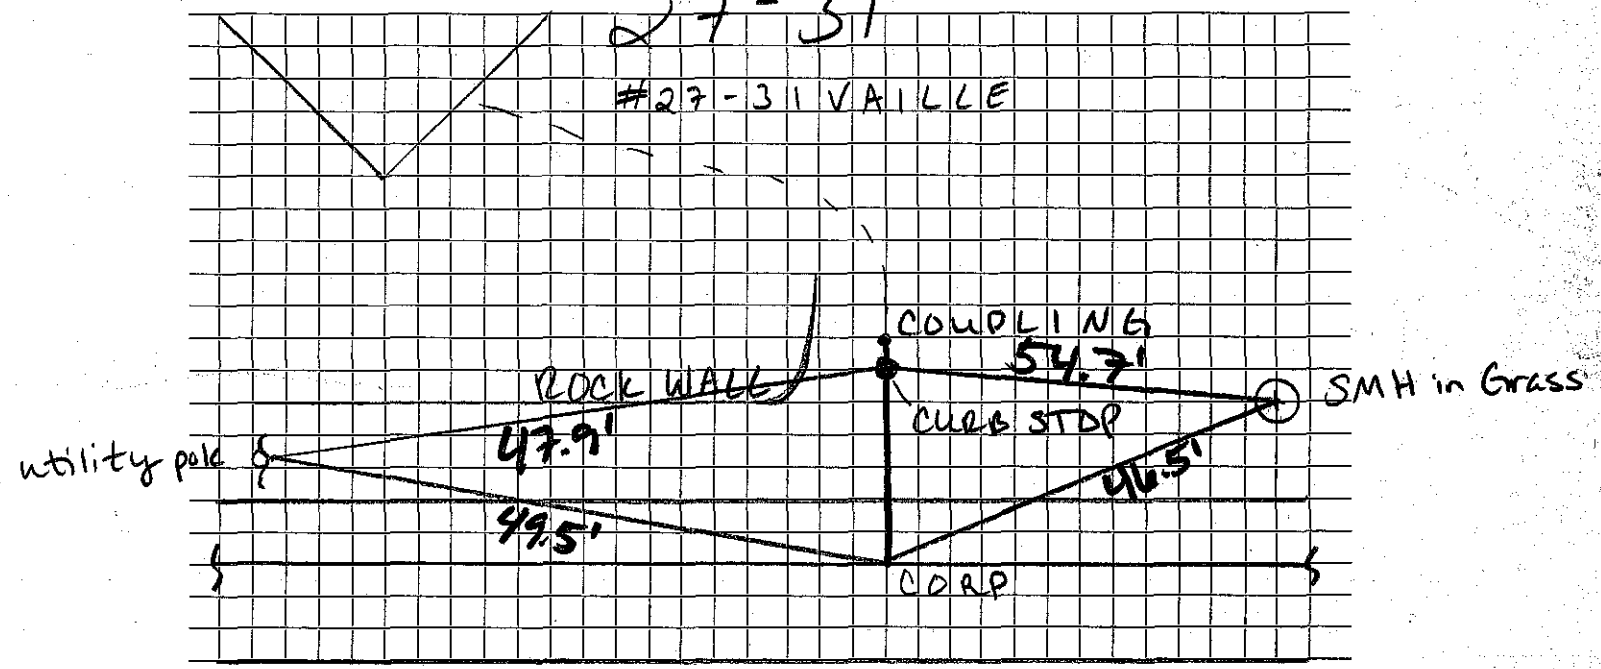

Connection made in Vaille Ave Street. Work completed

Remarks: New Service 1" from Curb to MAIN