Water Service Record

Address	ි	7	1	la:	۱۱	0	- 1	٧٠,	e
						ν,		$\neg \mathbf{v}$	·

Service No.

Location


Repair - Renewal - New Service

Date	Material	Amount	Total	Date	Amount
3/27/23	1 Copper	90`			
	1" Cub stop			and the second of the second o	
	Buthalo Box				
A Marine					

Date: 3/27/23

TOWN OF LEXINGTON - BOARD OF PUBLIC WORKS WATER DIVISON

SKETCH OF SERVICE HERE

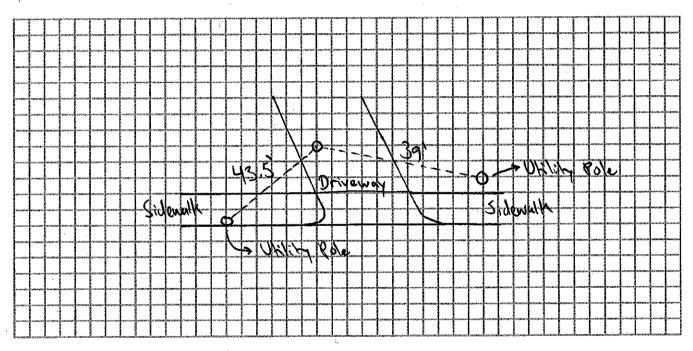

Connection made in:	,	Street.	Work completed:	
Remarks: Tustalled	By Kiely Ex	CAVATING		andidipotipalisi parisi nalimba non potigi paterparisi nalimba nalimba nalimba nalimba nalimba nalimba nalimba