


DATE _____

TOWN OF LEXINGTON — BOARD OF PUBLIC WORKS

WATER DIVISION

Sketch of Service Here

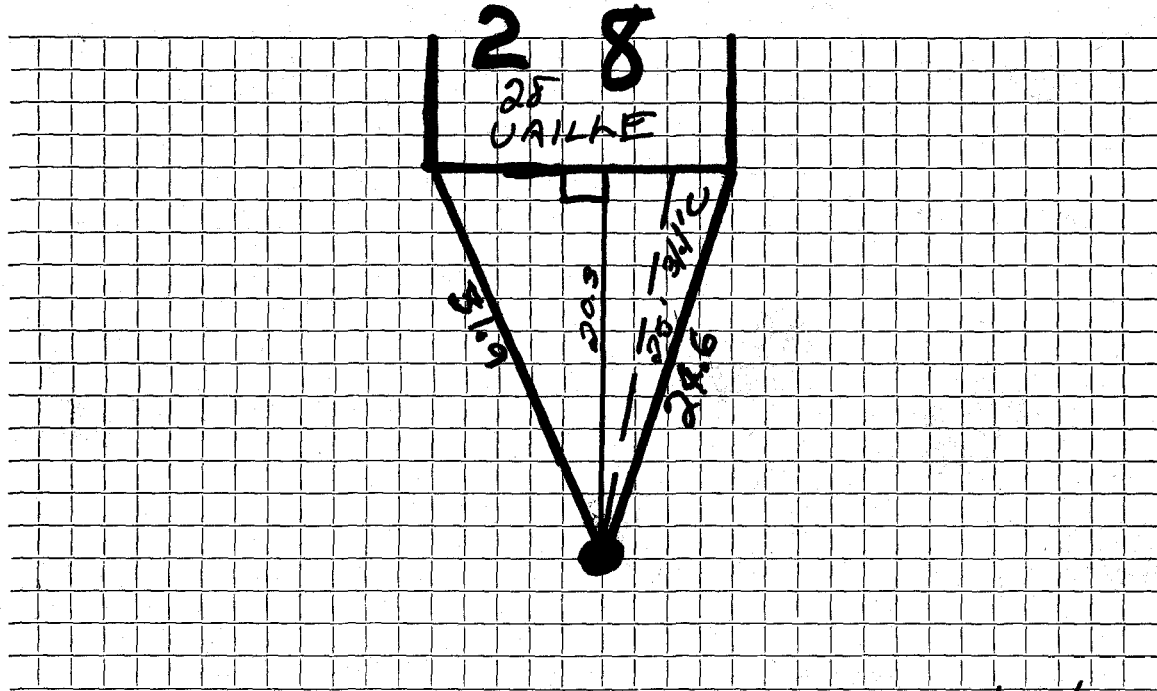

Connection made in 28 UAILLE RD Street.

Work completed 8/13/75

Remarks: Original Service 6-12-68