
		e Ma	artha A. Ryan	WATER SERVICE RECORD						1315 Service No.			
	Addr	ess 31	Vaille Avenue			e e e e e e e e e e e e e e e e e e e							
-	Location					e light have styll							
	Repa	ir—R	enewal—New Service										
	Date		Material	Amount		Total		Date			Amount		
<del></del>													
,													
<del></del>													
									l				
	<del></del>												
									-				
								-	<del></del>				
									<u> </u>				
									<del>                                     </del>				
		<del>-,</del>							<del> </del>				
·													
		<u> </u>							<del> </del>				
				,									
									-				
									1				

				4 .			
_		~	_		2 *		
D	^~		ᆮ		 	 	 

## TOWN OF LEXINGTON - BOARD OF PUBLIC WORKS

## WATER DIVISION

## Sketch of Service Here

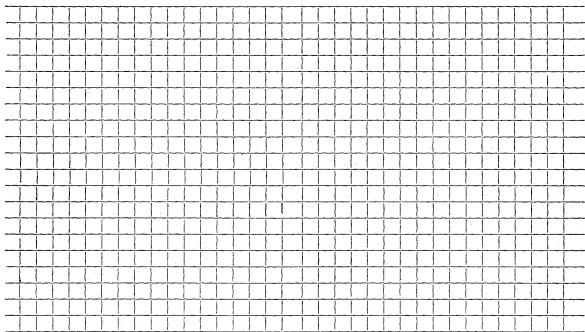

Connection made in .	.,	Street.	Work completed	· · · ·
Remarks:				
	• • • • • • • • • • • • • • • • • • • •	• • • • • • • • • • • • • • • • • • •	************************************	• • • •