

WATER SERVICE RECORD

Name Dave Paulik
 Address 32 Vaille Ave

Service No.

Location Contractor: Ventresca, Inc.

~~Repair~~ ~~Renewal~~ New Service


Date	Material	Amount	Total	Date	Amount
	EXISTING CURB to HOME			8/1/18	CURB to MAIN DEPTH
					1" x 3/4" Coupling
					1" Copper
					1" Curb Stop
				28'	1" Copper
					1" Corporation 5'
					type K pipe
					open right curb
					comb. brass

DATE 8/1/2018

TOWN OF LEXINGTON — BOARD OF PUBLIC WORKS

WATER DIVISION

Sketch of Service Here

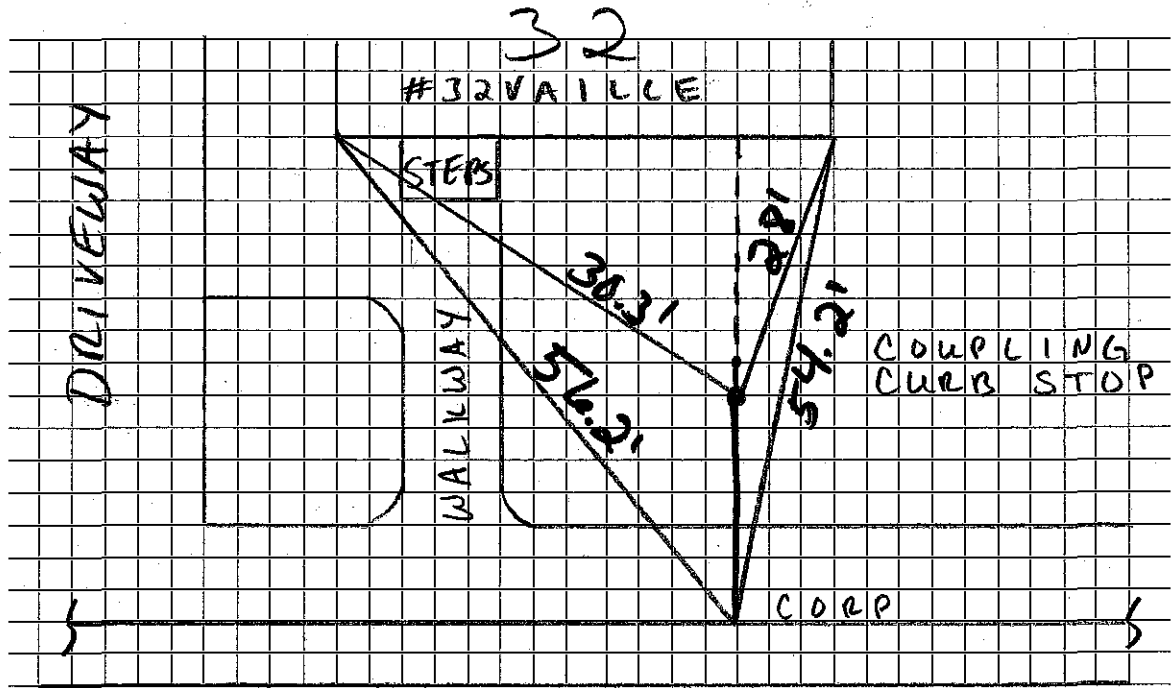

Connection made in Vaille Ave Street. Work completed

Remarks: New 1" Water service from Curb to Main