

Name **Mr. Ernest McPhabe**

Service No. **25 2718**

Address **Vaille Ave.**

Location **32 Vaille Ave.**

Kind of Pipe

Size

Size of Main

~~Repair - Renewal~~ - New Service

Location

Date	Material	Amount	Total	Date	Amount
<i>P. 7-29-30 for 20.25</i>	27' 1" C.L. Pipe @ .27	7 29			
	2 1" L.L. Coup. @ .30	60			
	2 1" L.L. Ells @ .35	70			
	2 1" Br. Sp. Nip. @ .25	50			
	1 S & W	3 00			
	Trucking	75	12 84		
4/28/30	7 Hrs. Labor @ .55	3 85		<i>Aug. 28 1930 - Cash</i>	20 25-
	2 " " @ .60	1 20	5 05		
	15% Overhead		76		
	COST		18 65		
	Labor				
CHARGE	27' @ \$.75	\$20 25			

Hadley Press, Inc. Lexington

DATE _____

TOWN OF LEXINGTON—BOARD OF PUBLIC WORKS

WATER DIVISION

The undersigned applies for a supply of water at No. _____ St. and hereby agrees to comply with the rules and regulations as now, or at any future time, established by the Board of Selectmen.


Am't. of Estimate \$ _____

Owner _____

Am't. Paid \$ _____

Address _____

Builder _____

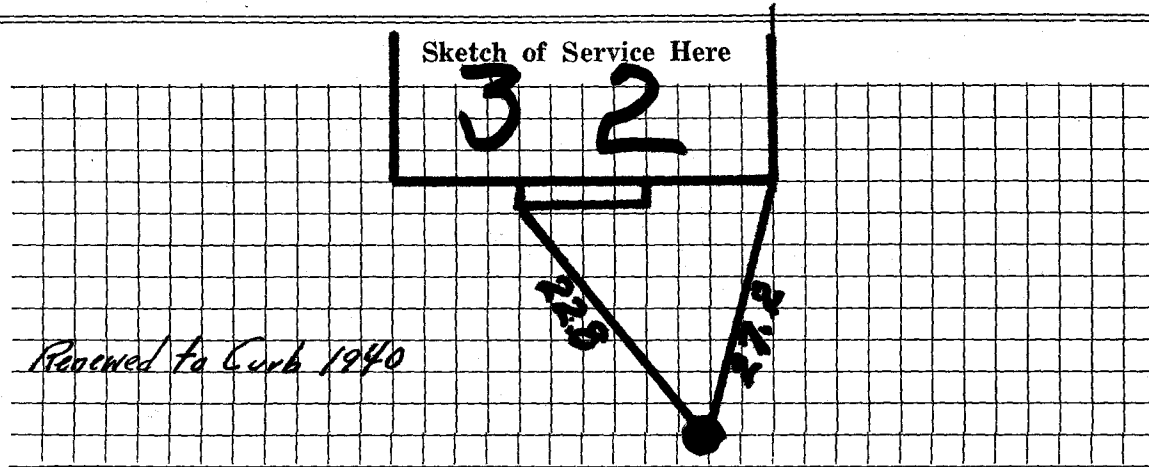

Connection made in _____ Street.

Work completed _____ 19

Remarks: