

WATER SERVICE RECORD

Name Marissa Liggiero  
 Address 35 Vaille Ave

Service No.

Location Contractor: Ventresca, Inc.


~~Repair~~ ~~Renewal~~ New Service

Date	Material	Amount	Total	Date	Material	Amount
	EXISTING			7/31/13	CURB to MAIN	
	CURB to HOUSE				DEPTH	
	3/4" Copper				1" x 3/4" Coupling	
				2"	1" Copper	
					1" Curb stop	4'6"
				10'	1" Copper	
					1" Corporation	4'6"
					type k pipe	
					open right curb	
					comb brass	

DATE 7/31/18

TOWN OF LEXINGTON — BOARD OF PUBLIC WORKS  
WATER DIVISION

Sketch of Service Here

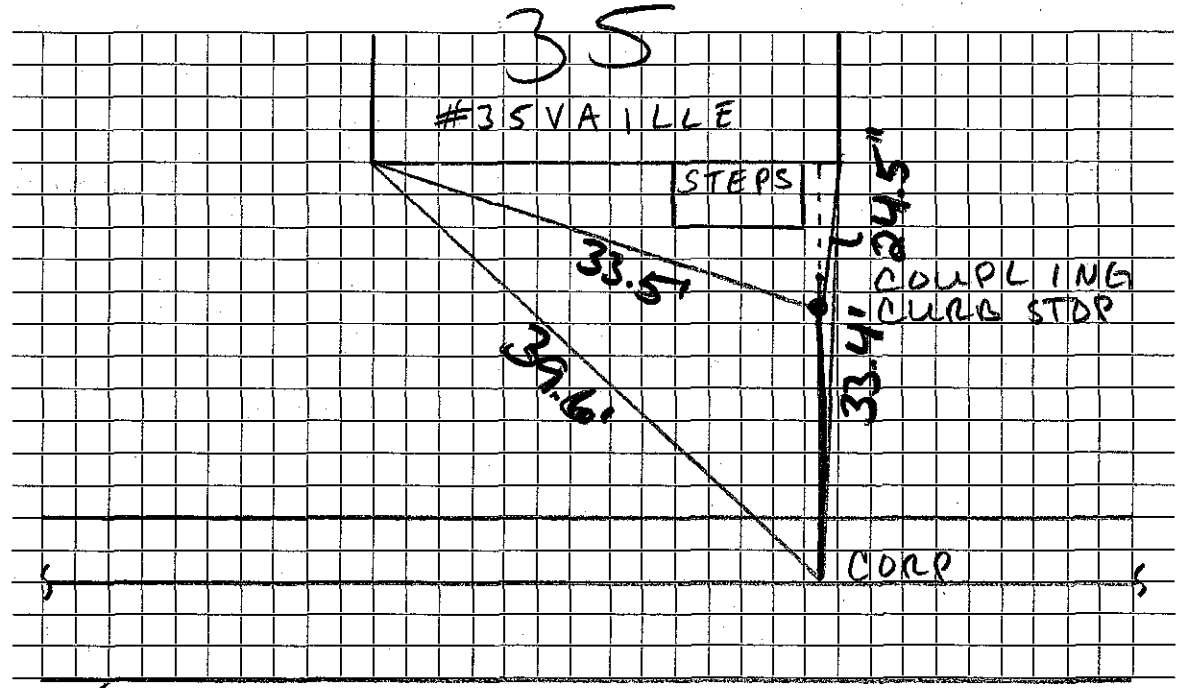

Connection made in... Vaile Ave ..... Street. Work completed .....

Remarks: New 1" Water Service from Curb to Main .....

.....

.....