

WATER SERVICE RECORD

Name Marissa Liggiero

Service No.

Address 36 Vaille Ave

Location

Contractor: Vantresca, Inc.

~~Repair~~ ~~Renewal~~ New Service


Date		Material	Amount	Total		Date	Amount
		EXISTING					
		3/4" Copper					
						CURB to MAIN	
						1" x 3/4" Coupling	
						1" Copper	
						1" Curb Stop	
						25' 1" Copper	
						1" Corporation	
						type K pipe	
						open right curb	
						comb brass	

DATE 8/3/18

TOWN OF LEXINGTON — BOARD OF PUBLIC WORKS

WATER DIVISION

Sketch of Service Here

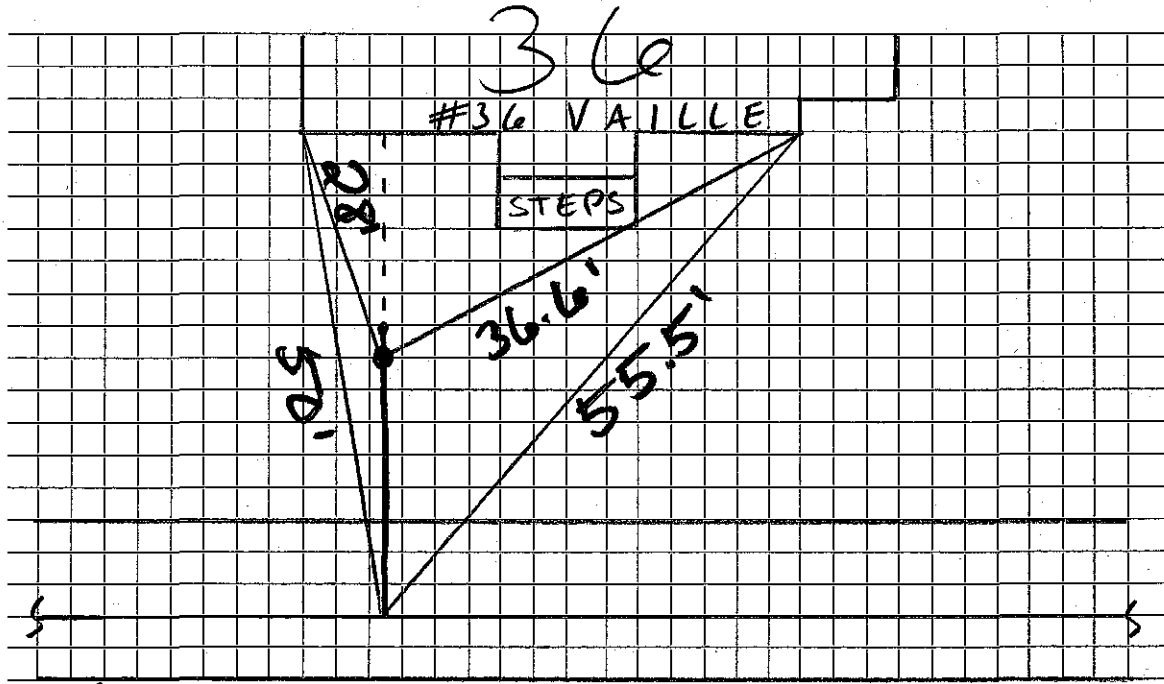

Connection made in... Vaillle Ave Street. Work completed

Remarks:.. New water service from curb to main

.....
.....