

WATER SERVICE RECORD

Name Marissa Liggiero

Service No.

Address 37 Vaille Ave

Location

Contractor: Ventresca, Inc.

~~Repair~~ ~~Renewal~~ New Service


Date	Material	Amount	Total	Date	Amount
	EXISTING CURB to HOUSE 1" Iron Pipe			7/31/18	CURB to MAIN DEPTH
				7/31/18	1" Coupling
				7/31/18	1' 1" Copper
				7/31/18	1" curb stop 4'6"
				7/31/18	13.5' 1" Copper
				7/31/18	1" Corporation 4'6"
				Total = 14.5'	
				Cu	
					type K pipe
					open right curb
					amb. brass

DATE 7/31/18

TOWN OF LEXINGTON — BOARD OF PUBLIC WORKS

WATER DIVISION

Sketch of Service Here

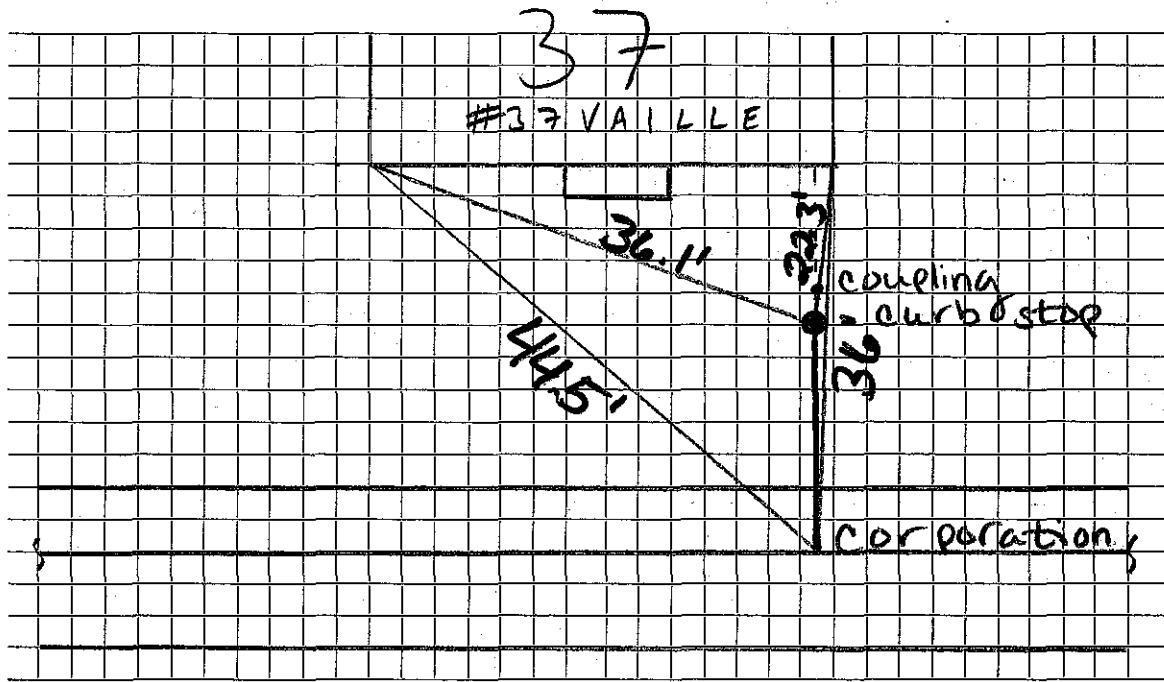

Connection made in Vaillle Ave Street. Work completed

Remarks: New 1" water service from curb to main