




DATE 10-26-2001

TOWN OF LEXINGTON — BOARD OF PUBLIC WORKS

WATER DIVISION

Sketch of Service Here

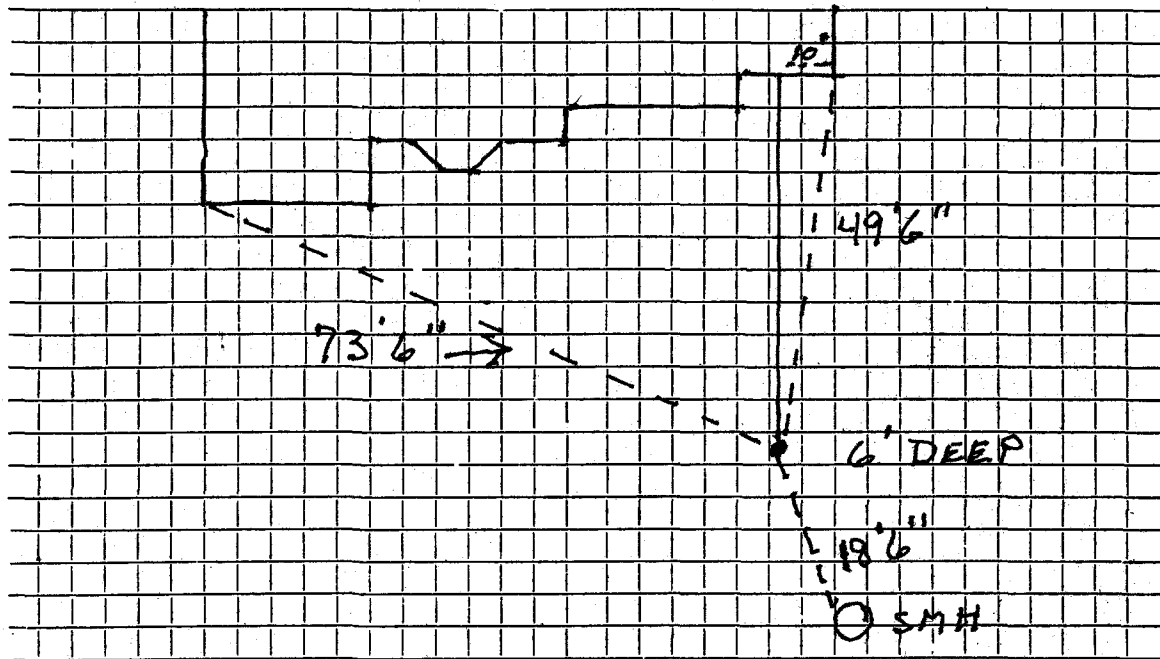

Connection made in VAILLE AVE Street. Work completed .....

Remarks: INSTALLED BY J. McLAUGHLIN .....