


DATE _____

TOWN OF LEXINGTON — BOARD OF PUBLIC WORKS
WATER DIVISION

Sketch of Service Here

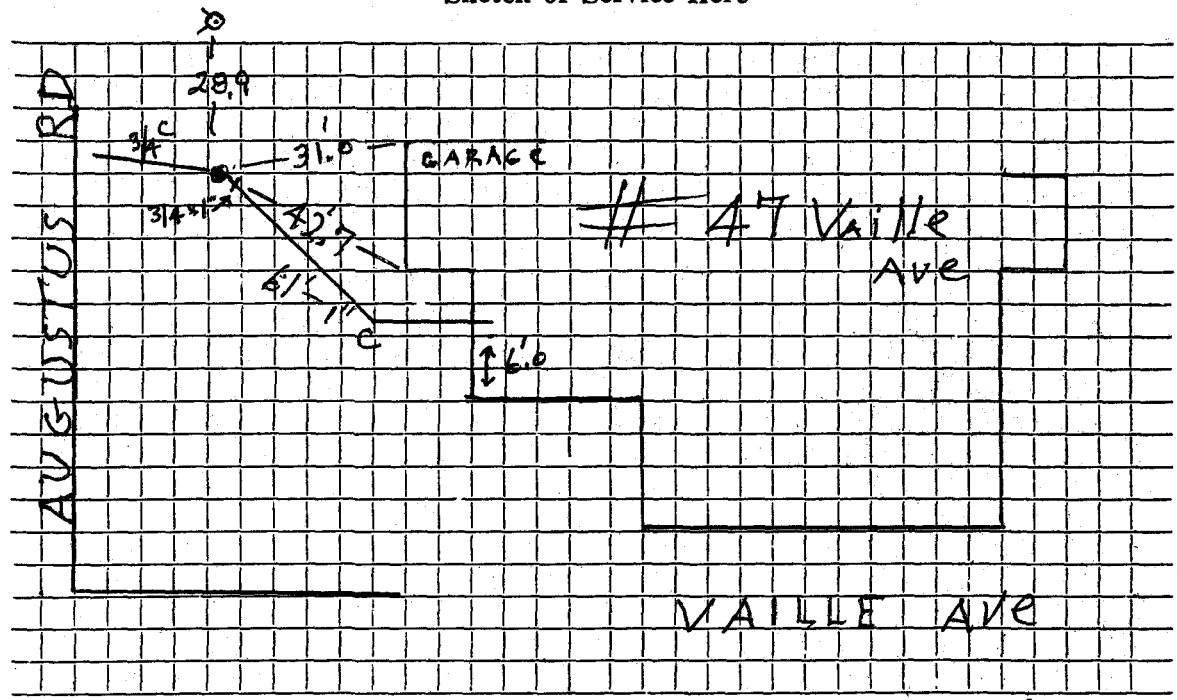

Connection made in Augustus RD Street.

Work completed 4/4/05 J. McLaughlin

Remarks:

.....

.....