


TOWN OF LEXINGTON — BOARD OF PUBLIC WORKS

WATER DIVISION

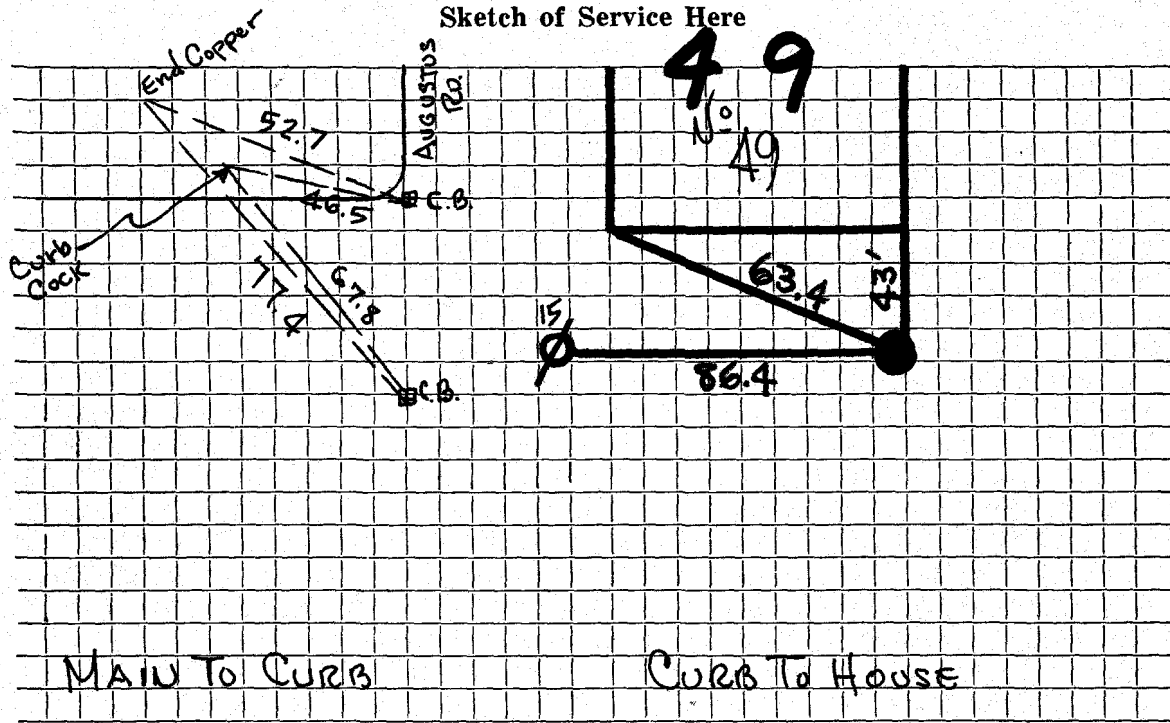

MAIN TO CURB

CURB TO HOUSE

Connection made in Street. Work completed

Remarks:
.....
.....