

WATER SERVICE RECORD

Name *Marissa Liaggiera*

Service No.

Address *6 Vaille Ave*

Location *Contractor: Ventresca, Inc.*

~~Repair~~ ~~Renewal~~ ~~New Service~~


Date	Material	Amount	Total	Date	Material	Amount
	<i>EXISTING</i>				<i>CURB to MAIN</i>	
	<i>3/4" Copper</i>				<i>1" x 3/4" Coupling</i>	
					<i>1" Copper</i>	
					<i>1" Curb Stop</i>	
				<i>25'</i>	<i>1" Copper</i>	
					<i>1" Corporation</i>	
					<i>type k copper</i>	
					<i>open right curb</i>	
					<i>comb. brass</i>	

DATE 8/18

TOWN OF LEXINGTON — BOARD OF PUBLIC WORKS

WATER DIVISION

Sketch of Service Here

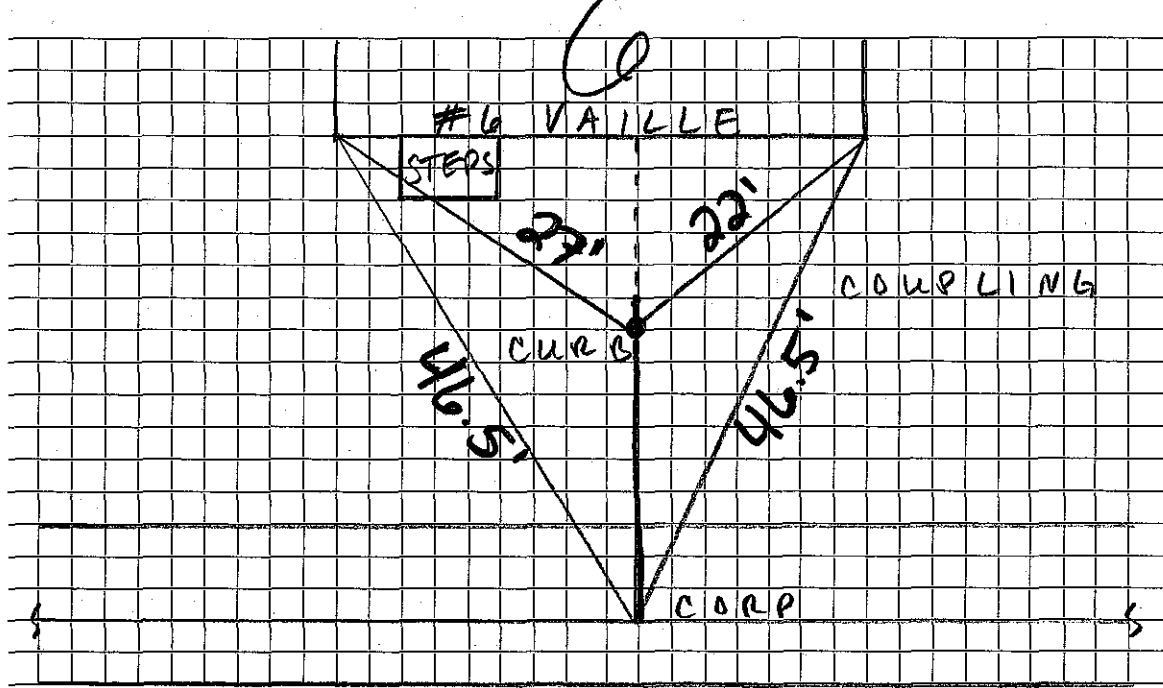

Connection made in Vaille Ave Street. Work completed

Remarks: New water service from curb to main