

Service No. 2709

#5989

Address

Location

6 Vaille Avenue.

Kind of Pipe

Size

Size of Main

~~Repair~~—Renewal—~~New Service~~

(Main to curb)

W. O. # 6746

Location

Date	Material	Amount	Total	Date	Amount
6/14/68	Labor	23 94			
	27' 3/4" Copperpipe @ .79	21 33			
	1- 3/4" Adaptor	2 76			
	1- 3/4" Curb Cock	11 32			
	1- 1" Coupling	60			
	1- 1"+4" Nipple	51			
	1- 1" Repair Clamp	5 05			
	1 Hr. Trucking	3 00			
	2 " Shovelling @ 6.50	13 00			
		81 51			
	Labor				

Hadley Press, Inc., Lexington

DATE _____

TOWN OF LEXINGTON—BOARD OF PUBLIC WORKS

WATER DIVISION

The undersigned applies for a supply of water at No. _____ St. and hereby agrees to comply with the rules and regulations as now, or at any future time, established by the Board of Selectmen.

Am't. of Estimate \$ _____

Owner

MacPherson


Am't. Paid \$ _____

Address

6 Vaille ave.

Builder _____

Sketch of Service Here

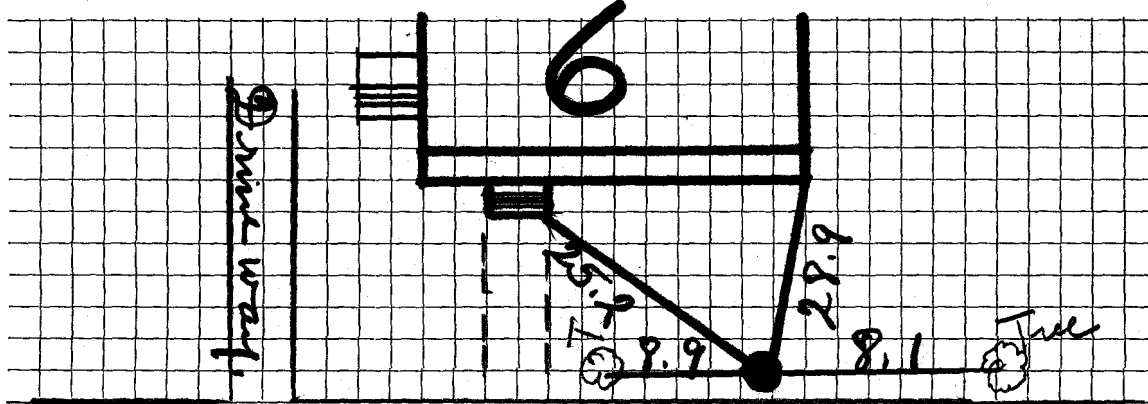

Connection made in _____

Vaille

Street ave.

Work completed _____

19

Remarks: