


DATE _____

TOWN OF LEXINGTON — BOARD OF PUBLIC WORKS

WATER DIVISION

Sketch of Service Here

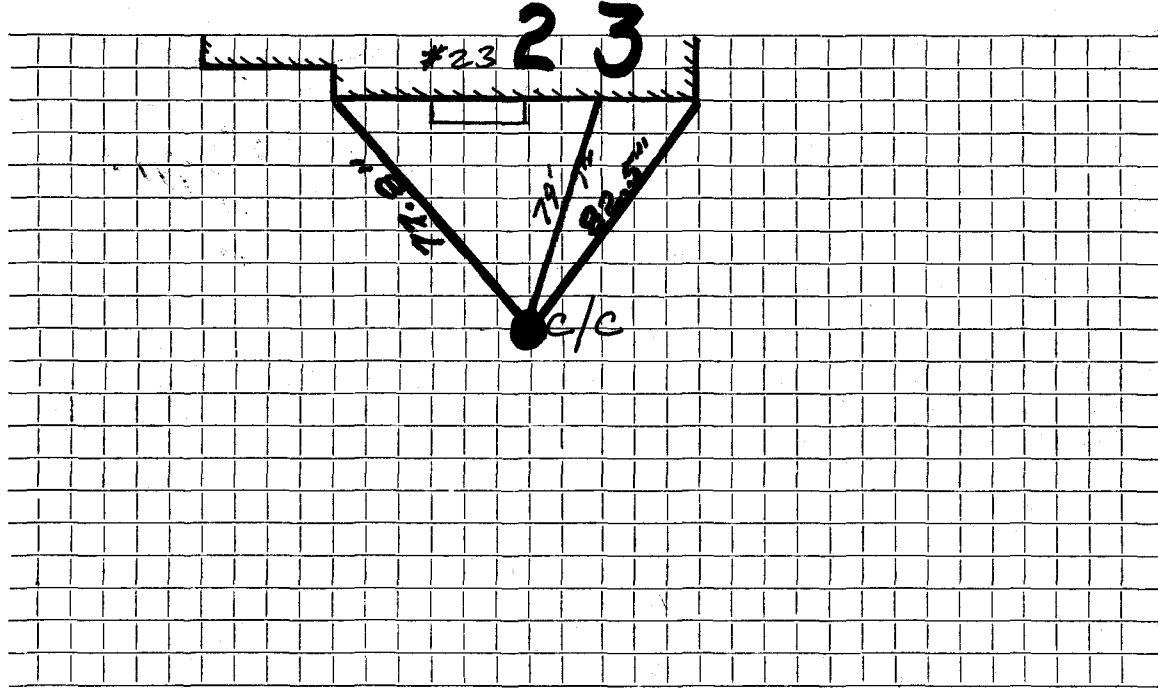

Connection made in VALLEY FIELD..... Street. Work completed

Remarks:
.....
.....