




DATE \_\_\_\_\_

TOWN OF LEXINGTON — BOARD OF PUBLIC WORKS

WATER DIVISION

Sketch of Service Here

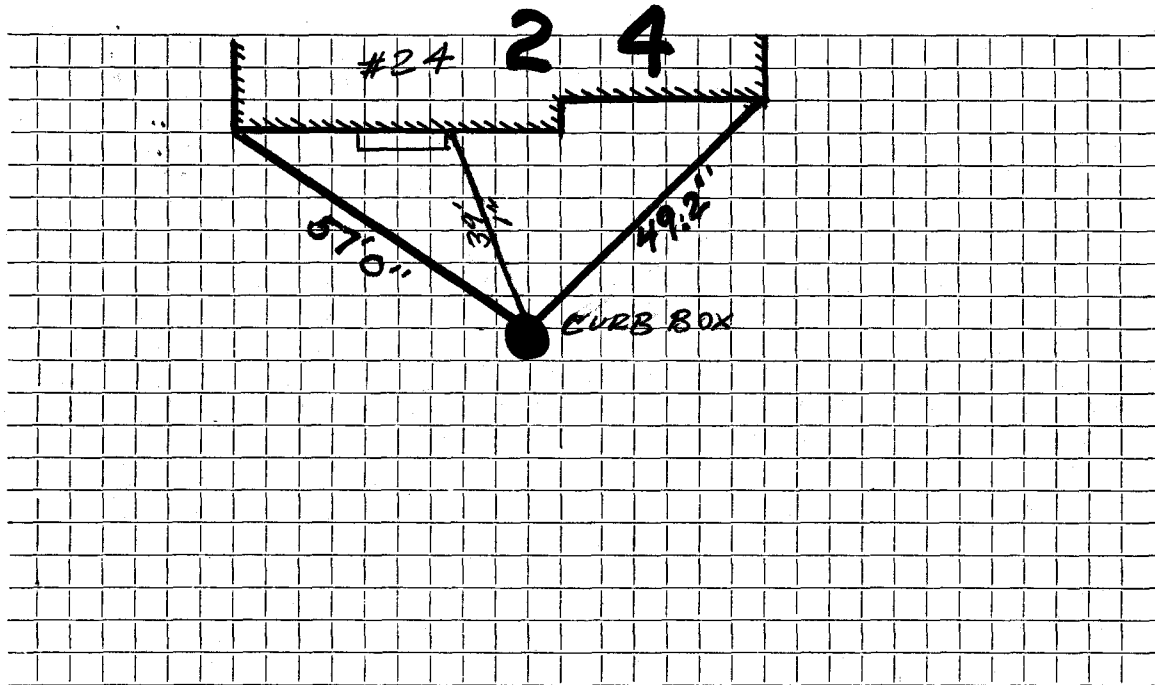

Connection made in ... VALLEY FIELD Street. Work completed .....

Remarks: No OUTSIDE TIES .....