




DATE \_\_\_\_\_

TOWN OF LEXINGTON — BOARD OF PUBLIC WORKS

WATER DIVISION

Sketch of Service Here

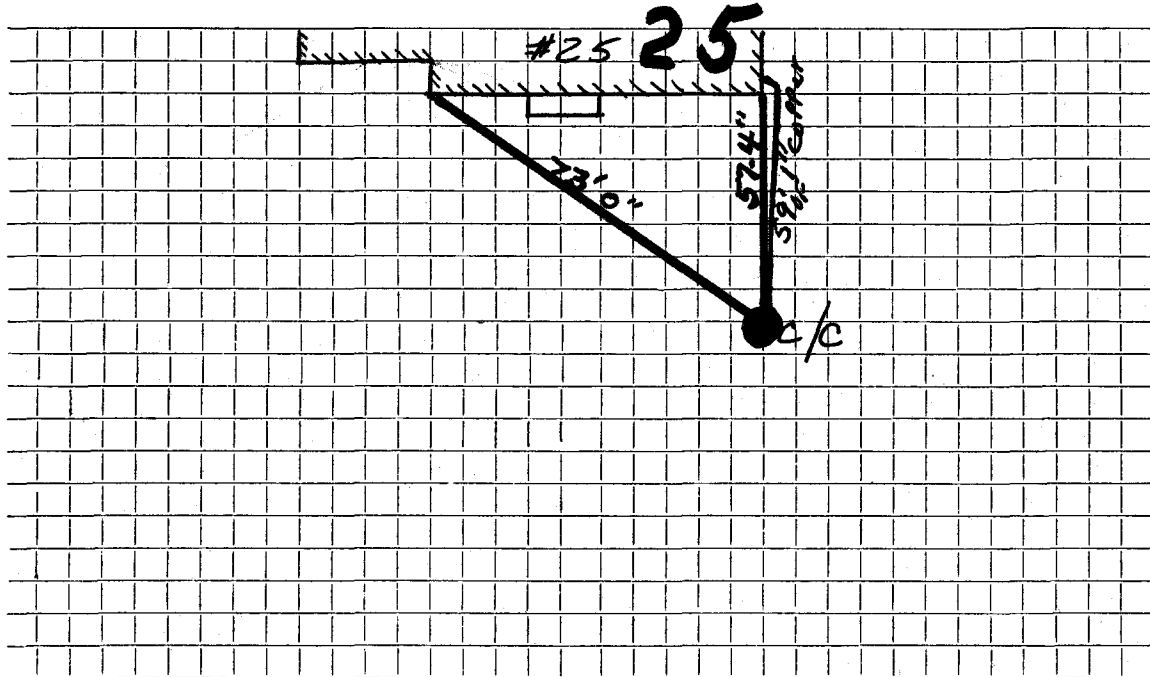

Connection made in VALLEY FIELD Street. Work completed .....

Remarks: NO OUTSIDE TIES .....