

WATER SERVICE RECORD

Name *William F. Hopkins*

2994

Service No. 97

Address *#27 Valleyfield Road St*

Location

~~Repair~~ ~~General~~ ~~New Service~~ *WO #3806*

SEP 5 1967


Date		Material	Amount		Total	Date	Amount
						<i>12-7-66</i>	<i>Deposit</i>
<i>12/13/66</i>		Labor	<i>40.</i>	<i>08</i>		<i>9-5-67</i>	<i>Retund</i>
		10% O.H.	<i>4.</i>	<i>01</i>	<i>44.</i>		<i>100 00</i>
		9' Copper			<i>7.</i>		<i>8 52</i>
		1 Box and Rod			<i>5.</i>		<i>91 48</i>
		1 3/4" Curb Cock			<i>8.</i>		
		1 3/4" Corp. Cock			<i>7.</i>		
		2 Hrs. Truck			<i>6.</i>		
		2 Hr. Backhoe			<i>13.</i>		
					<i>91.</i>		
<i>12-9-66</i>	<i>48'</i>	<i>3/4" Copper tubing</i>					

DATE _____

TOWN OF LEXINGTON — BOARD OF PUBLIC WORKS

WATER DIVISION

Sketch of Service Here

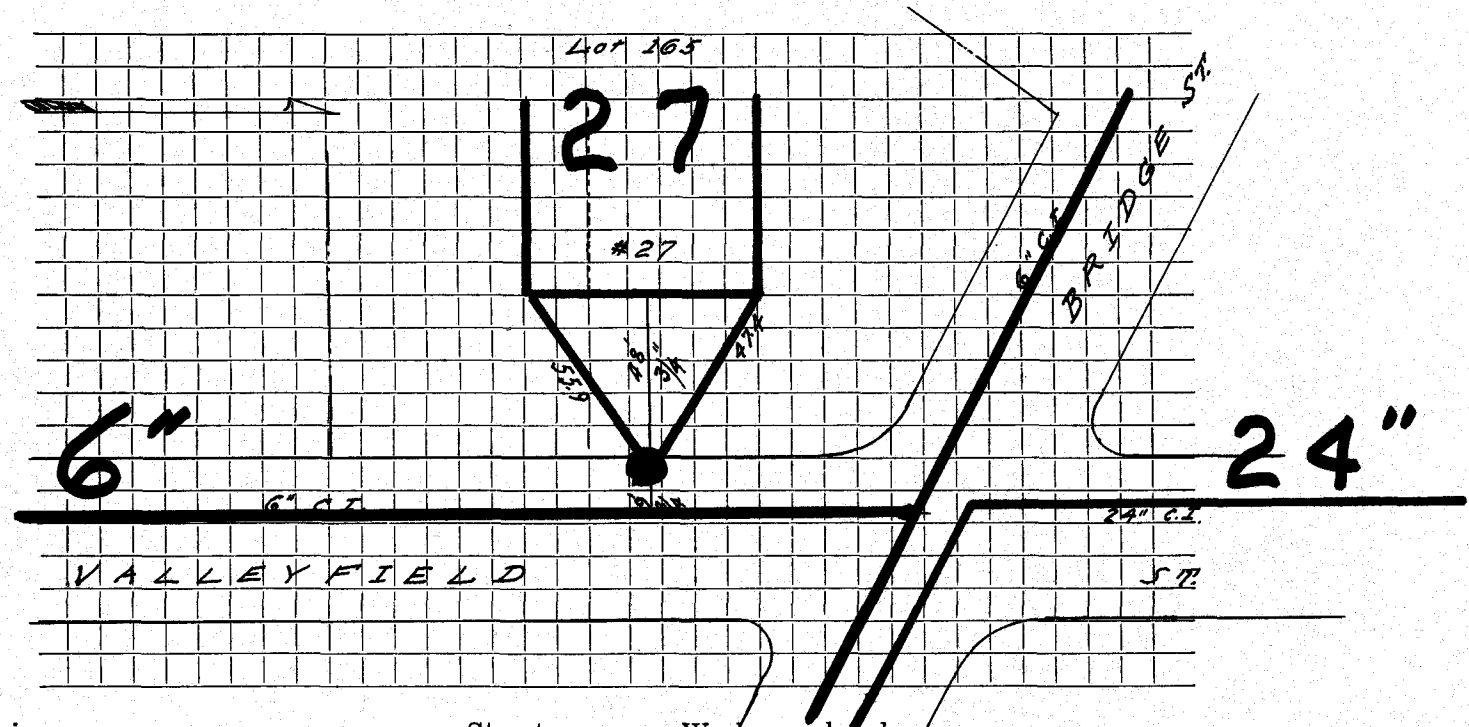

Connection made in Street. Work completed

Remarks:
.....
.....