

WATER SERVICE RECORD

Name Stratvern Realty

Service No. 84

Address 30 Valleyfield Street

Location Lot 122 Sta 1+0

Repair—Renewal—New Service Kirkland #898

MAY 13 1967


Date		Material	Amount	Total	Date	Amount
12-1-67	32'	3/4" Copper tubing			12-5-67	116.66
11-6-67		Labor	57.80			
		10% O.H.	5.78	63.58		
	20'	3/4" Copper Tubing @.79		15.80		
	1	3/4" Corp Cock		7.42		
	1	3/4" Curb Cock		8.76		
	1	Box & Rod		5.10		
	1	hr. Trucking @3.00		3.00		
	2	hr. Backhoe @6.50		13.00		
				116.66		

DATE _____

TOWN OF LEXINGTON — BOARD OF PUBLIC WORKS

WATER DIVISION

Sketch of Service Here

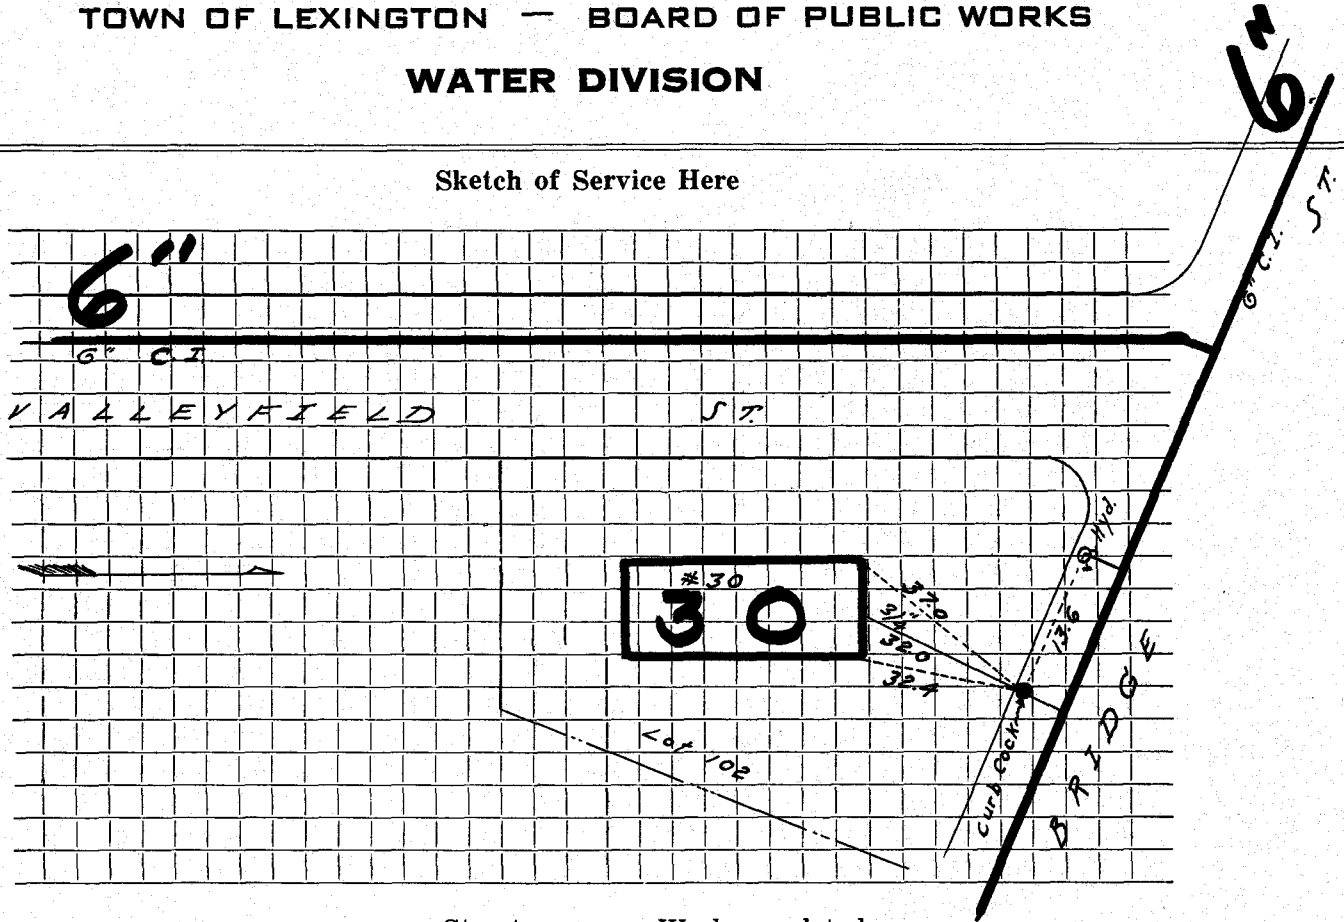

Connection made in Street. Work completed

Remarks:
.....
.....