

WATER SERVICE RECORD

Name Emerson Construction Co.

Service No.

36

Address 31 Valleyfield Street

Location Sta. 1+72 Right - Lot #166

~~Repair~~ Renewal - New Service W.O. #5511

Mckee # 2723

OCT 25 1976


Date	Material	Amount	Total	Date	Amount
				6-18-75	84 06
				Deposit	
10/11/67	Labor	31 92			
	O.H.	3 19	35 11		
23'	3/4" copper tubing @ .79		18 17		
1	3/4" Corporation		7 42		
1	3/4" Curb		8 76		
1	Box & Rod		5 10		
1	Hr. Shovel @ 6.50		6 50		
1	Hr. Trucking		3 00		
			84 06		

DATE _____

TOWN OF LEXINGTON — BOARD OF PUBLIC WORKS

WATER DIVISION

Sketch of Service Here

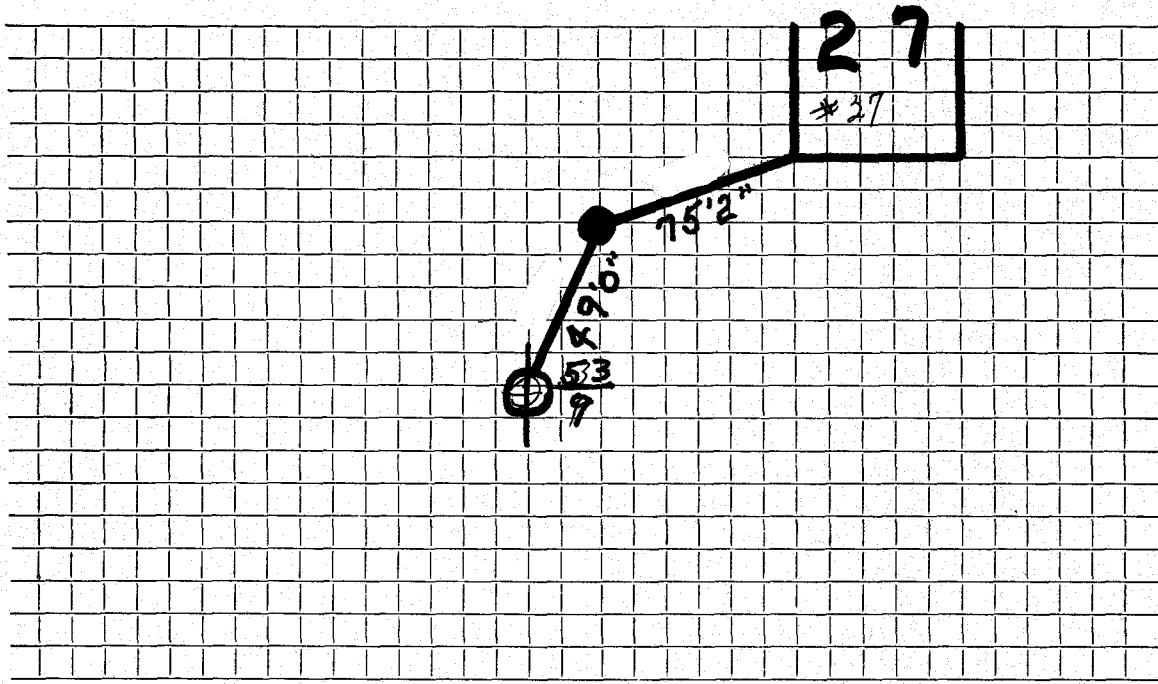

Connection made in Street. Work completed

Remarks:
.....
.....