

## WATER SERVICE RECORD

# 6788

Name George Forten

Service No. 61

Address 34 Valleyfield Street

# 7063

Location

~~Repair - Extension~~ - New Service DeFlice Brothers - Permit #376 - W.O.#597

MAR 14 1966


Date	Material	Amount	Total	Date	Amount
7/15/65	Labor	45 32		7-1-65	25 00
	10% O.H.	4 53	49 85	6-17-66	23 68
28'	3/4" copper tubing @ .42		11 76		98 68
1	3/4 Corp		7 41		
1	3/4 Curb		8 76		
1	Box & Rod		4 90		
1	Hr. Town Truck		3 00		
2	Hrs. Tractor @ 6.50		13 00		
			98 68		
7/7/65	54' 3/4" copper tubing				
					Bill sent 2368

DATE \_\_\_\_\_

TOWN OF LEXINGTON — BOARD OF PUBLIC WORKS

WATER DIVISION

Sketch of Service Here

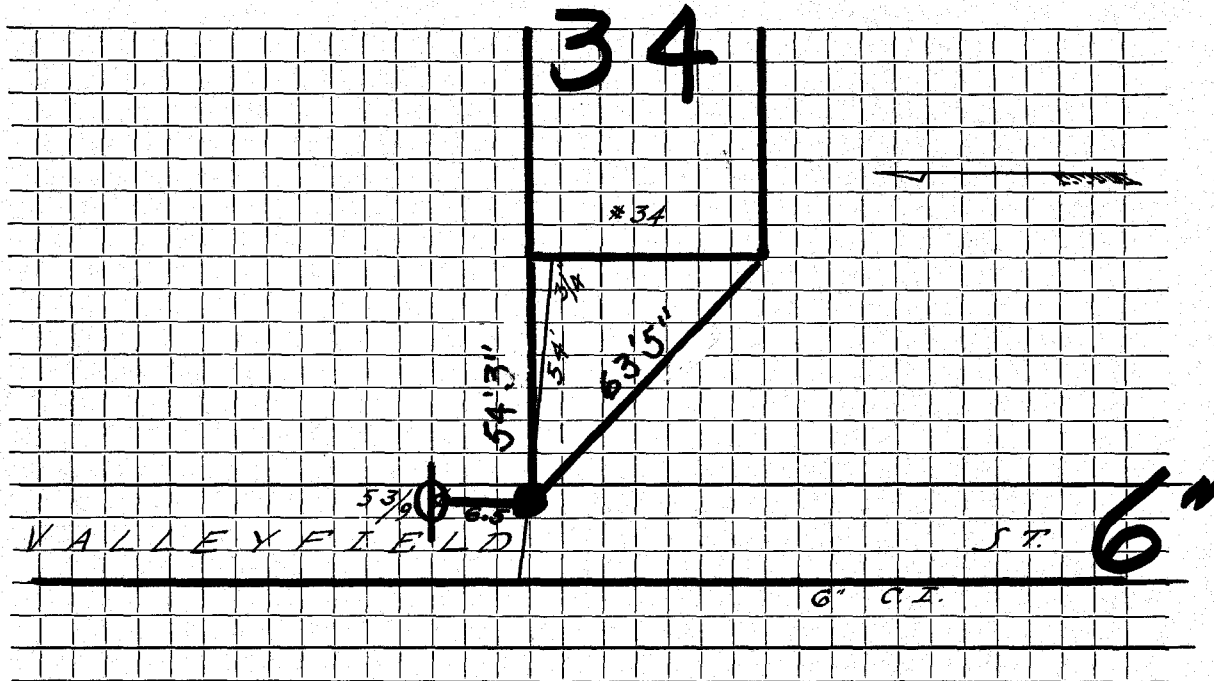

Connection made in ..... Street. Work completed .....

Remarks: .....  
.....  
.....