

WATER SERVICE RECORD

1132

Name Edward Domings

Service No. 35

Address 37 Valleyfield Street

Location Lot 168-169-170

Repair—Renewal—New Service W.O.#4937 Bonnanno#682

MAR 18 1968


Date		Material	Amount		Total		Date	Amount	
7-6-67	52'	3/4" Copper tubing					6-23-67	100	00
							3-18-68	11	34
6/26/67		Labor	34	59				88	76
		10% O.H.	3	46	38	05			
	17'	3/4" copperpipe @.79			13	43			
	1	3/4" corp.			7	42			
	1	3/4" curb cock			8	76			
		box & rod			5	10			
	2	hrs. shovel @6.50			13	00			
	1	hr. truck @3.00			3	00			
					88	76			

DATE _____

TOWN OF LEXINGTON — BOARD OF PUBLIC WORKS

WATER DIVISION

Sketch of Service Here

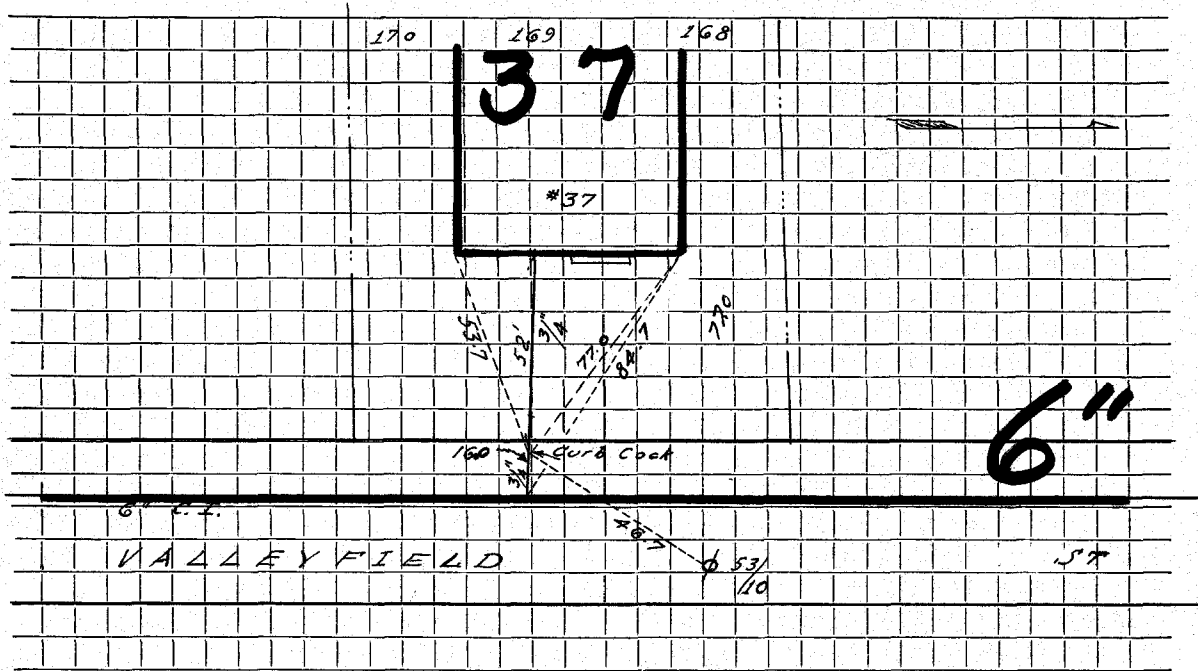

Connection made in Street. Work completed

Remarks:
.....
.....