


DATE 9-21-94

TOWN OF LEXINGTON — BOARD OF PUBLIC WORKS

WATER DIVISION

Sketch of Service Here

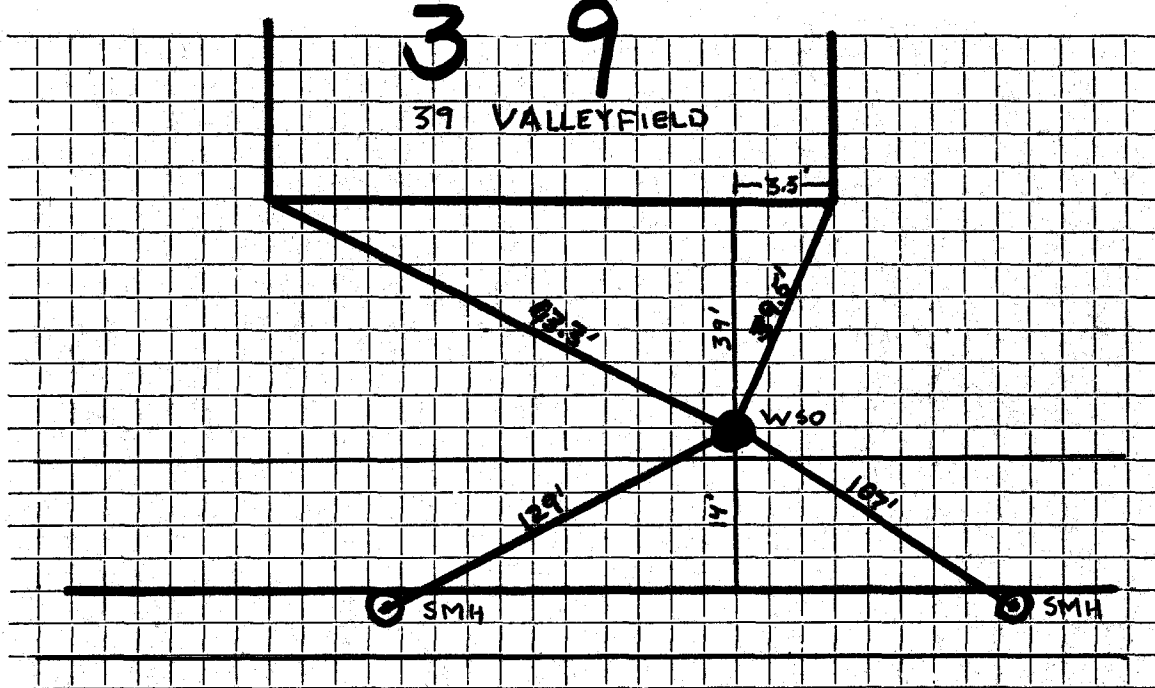

Connection made in ... VALLEYFIELD ... Street. Work completed

Remarks:
.....
.....