

## WATER SERVICE RECORD

Name Donna Realty Trust

Service No.

90

Address 40 Valleyfield Street

Location Lot #98 Sta. 3+74 left

Repair—Renewal—New Service Valeri #922

MAY 13 1968


Date	Material	Amount	Total	Date	Amount
12-21-67	46' 3/4" Copper tubing			12-26-67	126.72
10-24-67	Labor	42.12			
	10% O.H.	4.21	46.33		
	34' 3/4" Copper tubing @.79		26.86		
	1 3/4" Corp Cock		7.42		
	1 3/4" Curb Cock		8.76		
	1 Box & Rod		5.10		
	1 hr. Trucking @3.00		3.00		
			126.72		

DATE \_\_\_\_\_

# TOWN OF LEXINGTON — BOARD OF PUBLIC WORKS

## WATER DIVISION

Sketch of Service Here

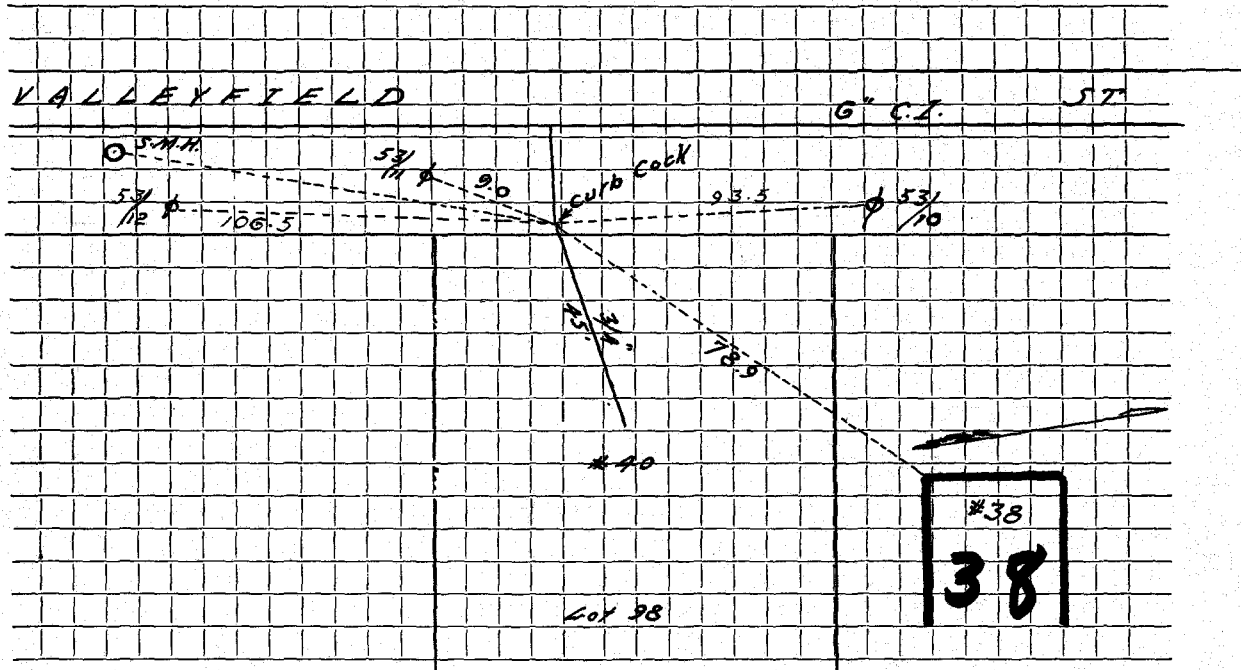

Connection made in ..... Street. Work completed .....

Remarks: .....

.....

.....