

WATER SERVICE RECORD

Name Page Associates

Service No. 29

Address 1 Valley Rd.

Location

Repair—Renewal—New Service W.O. #1109 Eagle #3107

FEB 10 1975

Date	Material	Amount	Total	Date	Amount
8/7/73	20' 3/4" Copper tubing			7-31-73	100 00
8/6/73	Labor	68.40		5-10-75	33 85
	10% O.H.	6.84	75.24	5-55-75	6 15
29'	3/4" Copper tubing @.60		17.40		139 87
1	3/4" Corp		9.57		
1	3/4" Curb Cock		11.32		
1	Box & Rod		7.34		
2	hr. Trucking @3.00		6.00		
2	hr. Town Shovel @6.50		13.00		
			139.87		


Deposit
Paid by SHIP #77
Paid

DATE _____

TOWN OF LEXINGTON — BOARD OF PUBLIC WORKS

WATER DIVISION

Sketch of Service Here

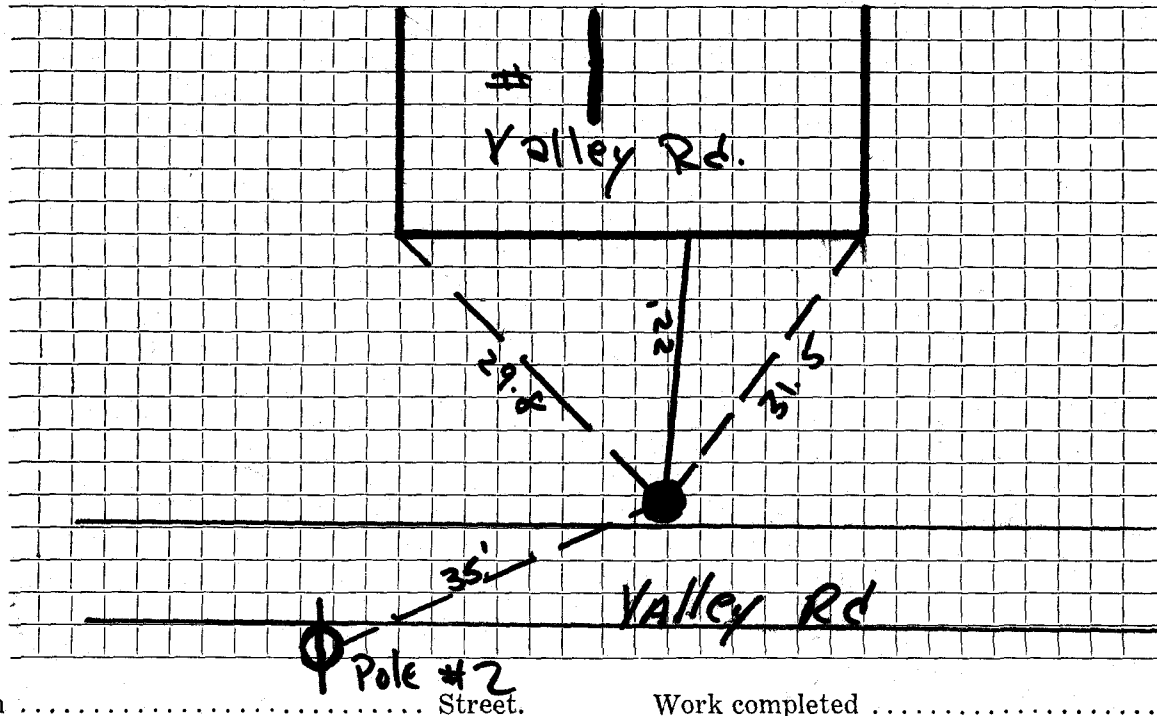

Connection made in Street. Work completed

Remarks:

.....

.....