

Name Donald K. Irwin

Service No. 31 #1966

Address 12 Valley Road

# 8842

Lexington, Mass.

Location 12 Valley Road

Kind of Pipe

Size

Size of Main

Repair—Renewal—New Service

Cmn. 5/22/50

Location

Date	Material	Amount	Total	Date	Amount
Apr. 18, '50	Labor	1 35	1 35	May 18 '50	15 00
	10% Overhead		14	May 22 '50	1 65
	34' - 3/4" Copper Tubing @.23		7 82		13 35
	1 - 3/4"C x 1/2" I.W.H. S&W		3 29	Apr. 18, '50	13 65
	Trucking 1 hr. @.75		75	26' - 3/4" Copper Tubing @.23	5 98
			13 35	1 - 3/4"C Corp-cock	3 15
				1 - 3/4"C x 3/4"C Curb-cock	3 85
				1 - Box & Rod	3 70
				1 - 1/2" Offset Tail Piece	38
				1 - 1/2" Straight Tail Piece	38
				Trucking 1 hr. @.75	75
					31 84
	Labor				

DATE \_\_\_\_\_

TOWN OF LEXINGTON - BOARD OF PUBLIC WORKS

**WATER DIVISION**

The undersigned applies for a supply of water at No..... St. and hereby agrees to comply with the rules and regulations as now, or at any future time, established by the Board of Selectmen.

Am't of Estimate \$.....

Owner .....


Am't Paid \$.....

Address .....

Builder .....

.....

Sketch of Service Here

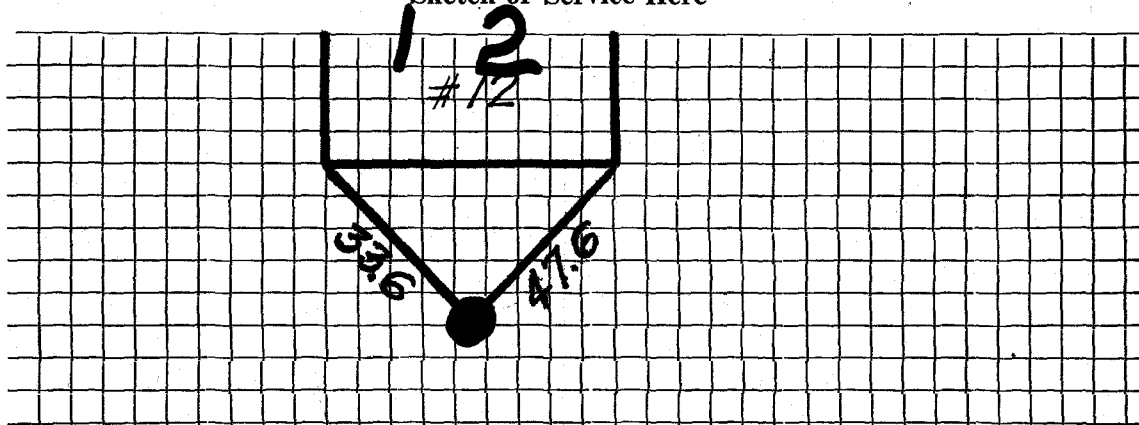

Connection made in ..... Street. Work completed .....19

Remarks: