

Name Thomas Ridd

Service No.

110
3360

Address 14 Valley Road

#6806

Location 14 Valley Road

Kind of Pipe

Size

Size of Main

~~Removal~~ Renewal—New Service

Com 12-1-47

Location

Date	Material	Amount	Total	Date	Amount
Sept. 15, '47	Labor	1 10	1 10	Sept 12 '47	Deposited 30 00
	10% Overhead		11	Dec 4 '47	Refunded 2 82
	27' - 3/4" Copper Tubing @ .26	7 02			Non-Charge 27 13
	1 - 3/4" C x 1/2" I.W.H. S & W	3 15		Sept. 13, '47	Labor 8 87
	Patching 15 x 3	15 00		" 15	" 27 10
	Trucking 1 hr. @ .75		75	20' - 3/4" Copper Tubing @ .26	5 20
			27 13	1 - 3/4" C Corp-cock	3 00
				1 - 3/4" C x 3/4" C Curb-cock	3 68
				1 - Box & Rod	4 26
				1 - 1/2" Straight Tail Piece	30
				1 - 1/2" Offset Tail Piece	30
				Trucking 1 hr. @ .75	75
	Labor				53 46

DATE _____

TOWN OF LEXINGTON – BOARD OF PUBLIC WORKS

WATER DIVISION

The undersigned applies for a supply of water at No..... St. and hereby agrees to comply with the rules and regulations as now, or at any future time, established by the Board of Selectmen.

Am't of Estimate \$.....

Owner


Am't Paid \$.....

Address

Builder

.....

Sketch of Service Here

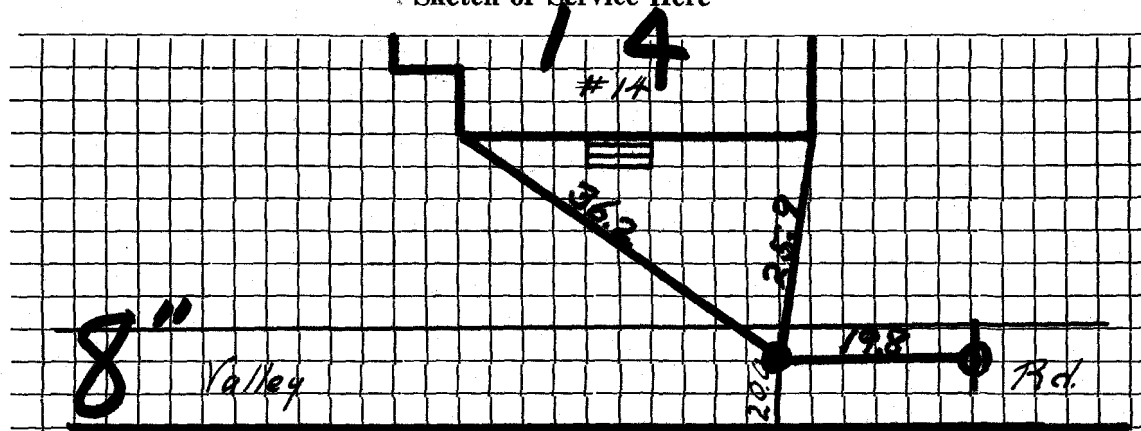

Connection made in Street.

Work completed19

Remarks: