

WATER SERVICE RECORD

Name Roderick J. Dermondy

Service No. 50

Address 15 Valley Road

Location Lexington

# 455

~~Revised Record~~ - New Service

Com. 3/30/53


Date	Material	Amount	Total	Date	Amount
3/16/52	Labor	1 63		3-9-53 Deposited	35 00
	10% overhead	16	1 79	3-30-53 Refunded	(8 06)
	60' - 3/4" copper tubing @ .34	20 40			<u>NON CHARGE</u>
	1 - 3/4" C x 1/2 I.W.H. stop & waste	4 00		3/16/53 Labor	1 63
	1 hr. trucking		75	18' - 3/4" copper tubing @ .34	6 12
			<u>26 94</u>	1 - 3/4" C. corp-cock	4 33
				1 - 3/4" C x 3/4" C. curb-cock	4 67
				1 box and rod	3 90
				1 - 1/2 straight tail pc.	50
				1 - 1/2 offset tail pc.	50
				1 hr. trucking	75
					<u>22 40</u>

DATE \_\_\_\_\_

TOWN OF LEXINGTON — BOARD OF PUBLIC WORKS

WATER DIVISION

Sketch of Service Here

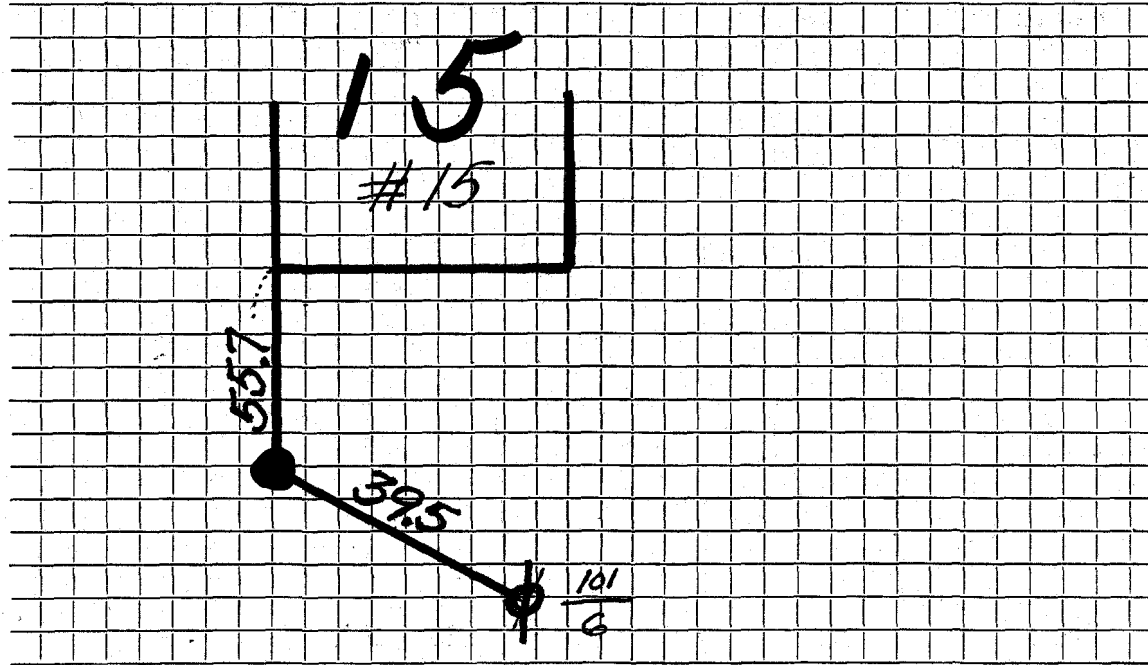

Connection made in ..... Street. Work completed .....

Remarks: .....

.....

.....