

WATER SERVICE RECORD

Name **Joseph H. Casey**

Service No. **216**

Address **18 Valley Road**

2115
D **2423**

Location

~~Maplewood~~ - New Service

Com. f-31-53


Date	Material	Amount	Total	Date	Amount
8/4/53	Labor	1 75		7-29-53	25 -
	10% overhead	18	1 93	f-31-53	1 26
	47' - 3/4" copper tubing@.3629		17 06		<u>NON CHARGE</u>
	1 -3/4"C x 1/2 I.W.H. stop & waste		4 00	8/4/53	Labor
	1 hr. trucking		75		18' - 3/4" copper tubing@.3629
			<u>23 74</u>		1 -3/4" C. corp-cock
					1 -3/4"C. x 3/4"C. curb-cock
					1 box and rod
					1 -1/2 straight tail pc.
					1 -1/2 offset tail pc.
					1 hr. trucking
					<u>75</u>
					<u>22 93</u>

DATE _____

TOWN OF LEXINGTON — BOARD OF PUBLIC WORKS

WATER DIVISION

Sketch of Service Here

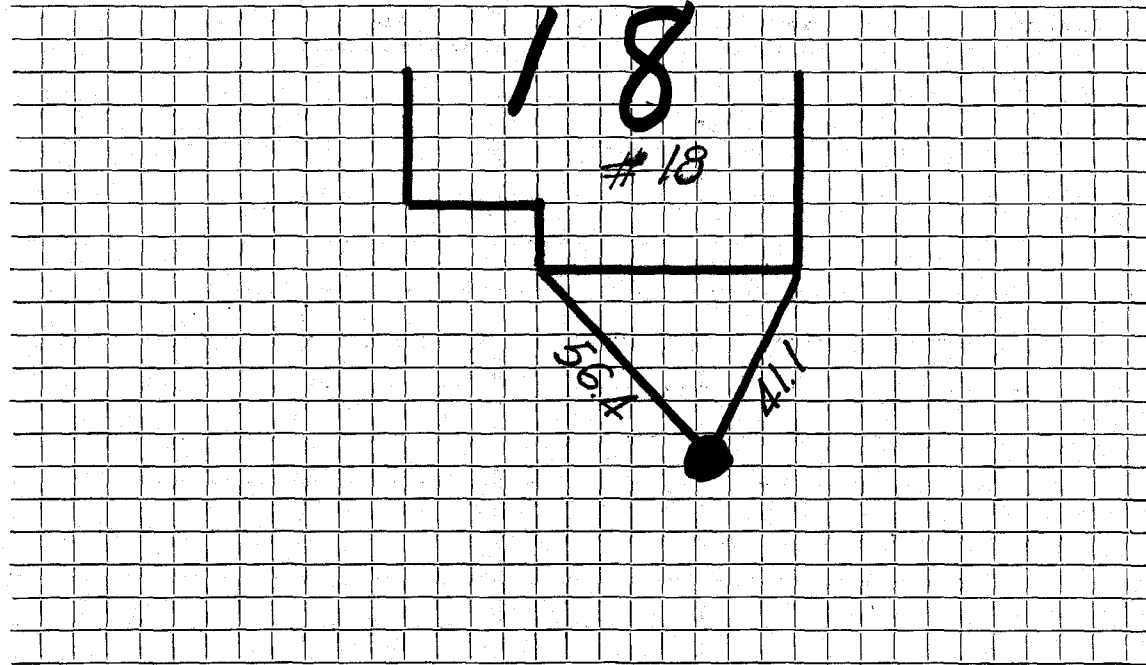

Connection made in Street. Work completed

Remarks:
.....
.....