

Name Charles McNamara

Service No. 27 2724

Address 19 Valley Road

Location 12 Sterling St., Somerville

Kind of Pipe

Size

Size of Main

~~Repair - Renewal~~ - New Service

Location

Date	Material	Amount	Total	Date	Amount
7/16/30	24' 2" Service @.95	22 80			
P. 7-19-30 for 32.05	1 2" Valve	9 25	\$32 05	Dec. 26 1930 - Cash	32 05
				APR 10-2-30 12-11-30	
	Labor				

Hadley Press, Inc., Lexington

DATE _____

TOWN OF LEXINGTON—BOARD OF PUBLIC WORKS

WATER DIVISION

The undersigned applies for a supply of water at No. _____ St. and hereby agrees to comply with the rules and regulations as now, or at any future time, established by the Board of Selectmen.

Am't. of Estimate \$ _____


Owner _____

Am't. Paid \$ _____

Address _____

Builder _____

Sketch of Service Here

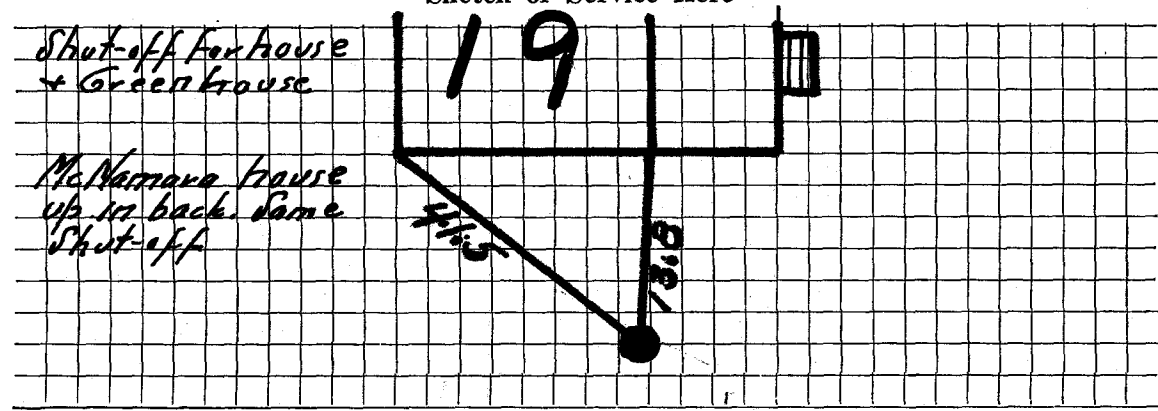

Connection made in _____ Street.

Work completed _____ 19

Remarks: