

## WATER SERVICE RECORD

Name Henry J. Bass

Service No. 40

Address 25 Valley Rd.

Location

~~Repair~~—Renewal—~~New Service~~ W.O. # 6835

DEC 22 1969


Date	Material	Amount	Total	Date	Amount
9/18/69	Labor		95 17	9-18-69	250 00
	10% O.H.		9 52	12-22-69	56 49
54'	3/4" Copper pipe	.79	42 62		193 51
1	3/4" Wheel Valve		9 30	11-8-'66'	
3	Yds. Loam	3.50	10 50	12' 3/4" Copper	
4	Lbs. seed	1.10	4 40	<del>1 1/4" Repair Clamp</del>	
3	Hrs trucking	3.00	9 00	<del>1 6" Coupling</del>	
2	" shovel	6.50	13 00	<del>1 1/2" X 1" Reducing Coupling</del>	
			193 51	1 3/4" Curb Cock	
				<del>1 3/4" Plug</del>	
				1 1" Adapter	
				1 Box + Rod	

DATE \_\_\_\_\_

TOWN OF LEXINGTON -- BOARD OF PUBLIC WORKS

**WATER DIVISION**

Sketch of Service Here

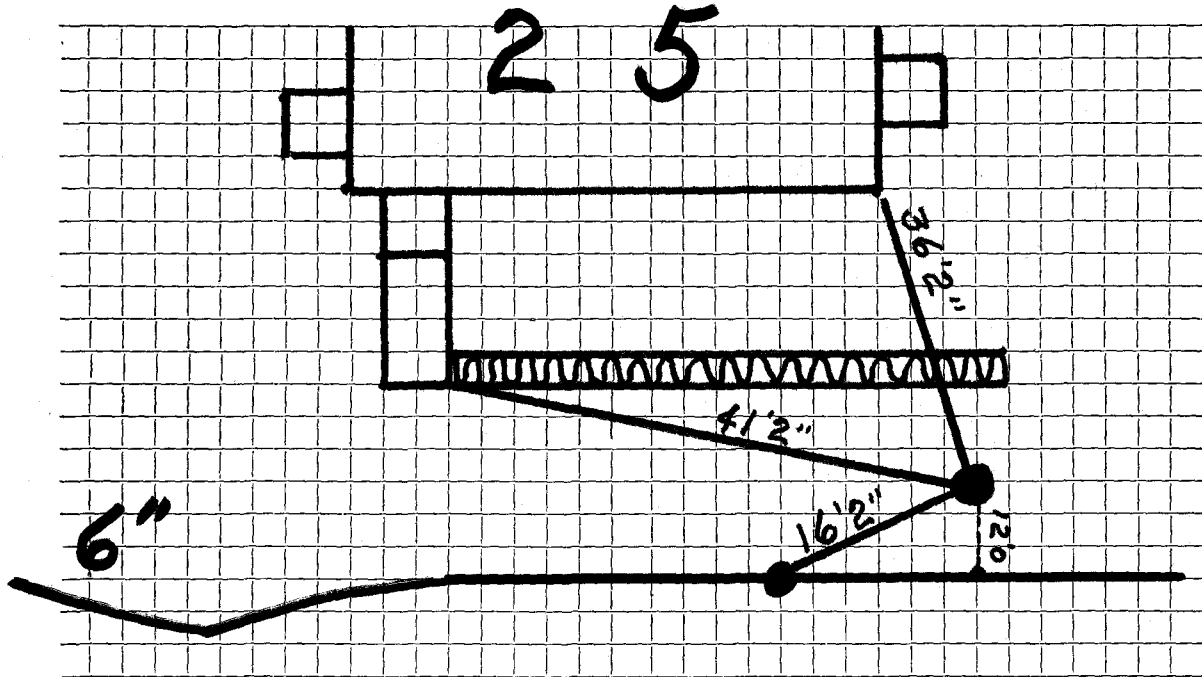

Connection made in ..... Street. Work completed .....

Remarks: .....  
.....  
.....