

WATER SERVICE RECORD

Name Joseph E. Casey

Service No. 248

Address 28 Valley Road

2544

Location Lexington, Mass.

~~XXXXXXXXXX~~ - New Service

Com. 11-13-51


Date	Material	Amount	Total	Date	Amount
10/19/51	Labor	1 49	1 49	10-15-51	Deposited 25 -
	10% overhead		15	11-13-51	Refunded 8 83
	30' - 3/4" copper tubing @ .326	9 78			<u>NON CHARGE</u> 16 17
	1 - 3/4" C x 1/2 I.W.H. stop & waste	4 00		10/19/51	Labor 1 49
	1 hr. trucking		75	15' - 3/4" copper tubing @ .326	4 89
			16 17	1 - 3/4" C. corp-cock	4 33
				1 - 3/4" C x 3/4" C. curb-cock	4 67
				1 - box and rod	4 68
				1 - 1/2 offset tail piece	50
				1 - 1/2 straight tail piece	50
				1 hr. trucking	75
					<u>21 81</u>

DATE _____

TOWN OF LEXINGTON — BOARD OF PUBLIC WORKS

WATER DIVISION

Sketch of Service Here

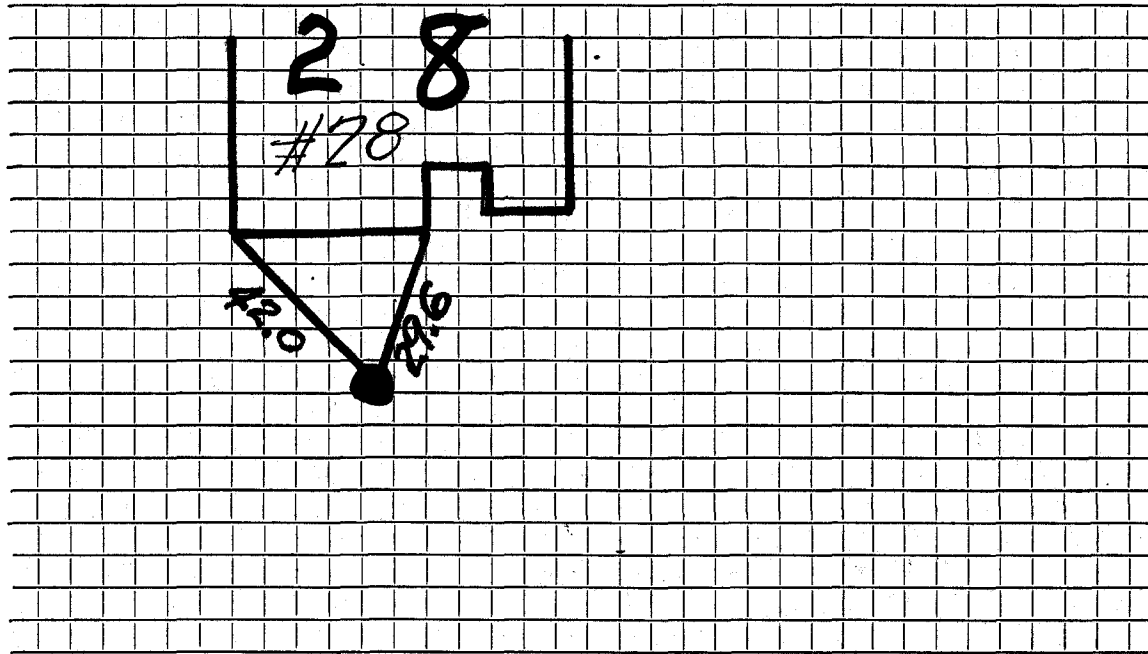

Connection made in Street. Work completed

Remarks:

.....

.....